


The 14 plans Numbered/Rev: 1/C03, 2/C02, 3/C02, 4/C02, 5/C03, 6/C02, 7/C02, 8/C02, 9/02, 10/C02, 11/C02 12/C02, 13/C02 and 14/C02 contained in this Order have been replaced by the revised 14 plans Numbered/Rev 1/P11, 2/P10, 3/P10, 4/P10, 5/P11, 6/P10, 7/P10, 8/P10, 9/P11.1, 10/P11.1, 11/P10, 12/P10, 13/P08 and 14/P08 by modification by the Secretary of State for Transport upon confirmation of the Order by her.


THE LINCOLNSHIRE COUNTY COUNCIL  
(A1461 NORTH HYKEHAM RELIEF ROAD,  
CLASSIFIED ROAD)  
(SIDE ROADS) ORDER 2024


CONTENTS;	KEY
1 SRO MASTERPLAN	<input type="checkbox"/> S* HIGHWAY TO BE STOPPED UP
14 SRO SITE PLANS (1/2/3/4/5/6/7/8/9/10/11/12/13/14)	<input type="checkbox"/> H* HIGHWAY TO BE IMPROVED
THESE PLANS SHOW THE ROUTE OF THE HIGHWAYS, THE SITES OF IMPROVEMENT, STOPPING UP AND NEW ACCESSES, BUT NO WIDTHS DETAILS OR BALANCING POND DETAILS ARE SHOWN.	<input type="checkbox"/> N* ROUTE OF NEW HIGHWAY
<b>THE SRO KEY PLAN SCALES;</b>	<input type="checkbox"/> X* PRIVATE MEANS OF ACCESS STOPPED UP
FOR THE SRO MASTERPLAN, 1:10,000	<input type="checkbox"/> * NEW PRIVATE MEANS OF ACCESS
FOR THE 14 MAIN SRO SITE PLANS 1:2500	<input type="checkbox"/> — EXISTING HIGHWAY BOUNDARY
REFER TO GENERAL NOTES PROVIDED IN THE LINCOLNSHIRE COUNTY COUNCIL (A1461 NORTH HYKEHAM RELIEF ROAD, CLASSIFIED ROAD) (SIDE ROADS) ORDER 2024 SCHEDULE FOR GENERAL INFORMATION AND INSTRUCTION ON THE SRO SCHEDULE	<input type="checkbox"/> — PROPOSED HIGHWAY BOUNDARY
	<input type="checkbox"/> UCR DENOTES UNCLASSIFIED ROAD
	<input type="checkbox"/> FP DENOTES PUBLIC FOOTPATH
	<input type="checkbox"/> ● # MEASURE TAKEN FROM POINT

The Common seal of the Lincolnshire County Council


Was hereunto affixed on this day, in the presence of

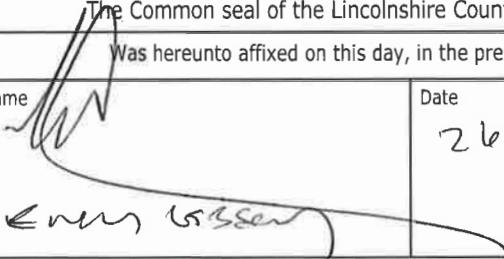
Authorised Signature	Name	Date
		26 <sup>th</sup> September 2024

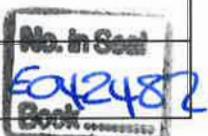
Seal of the Lincolnshire County Council	
Seal No.	

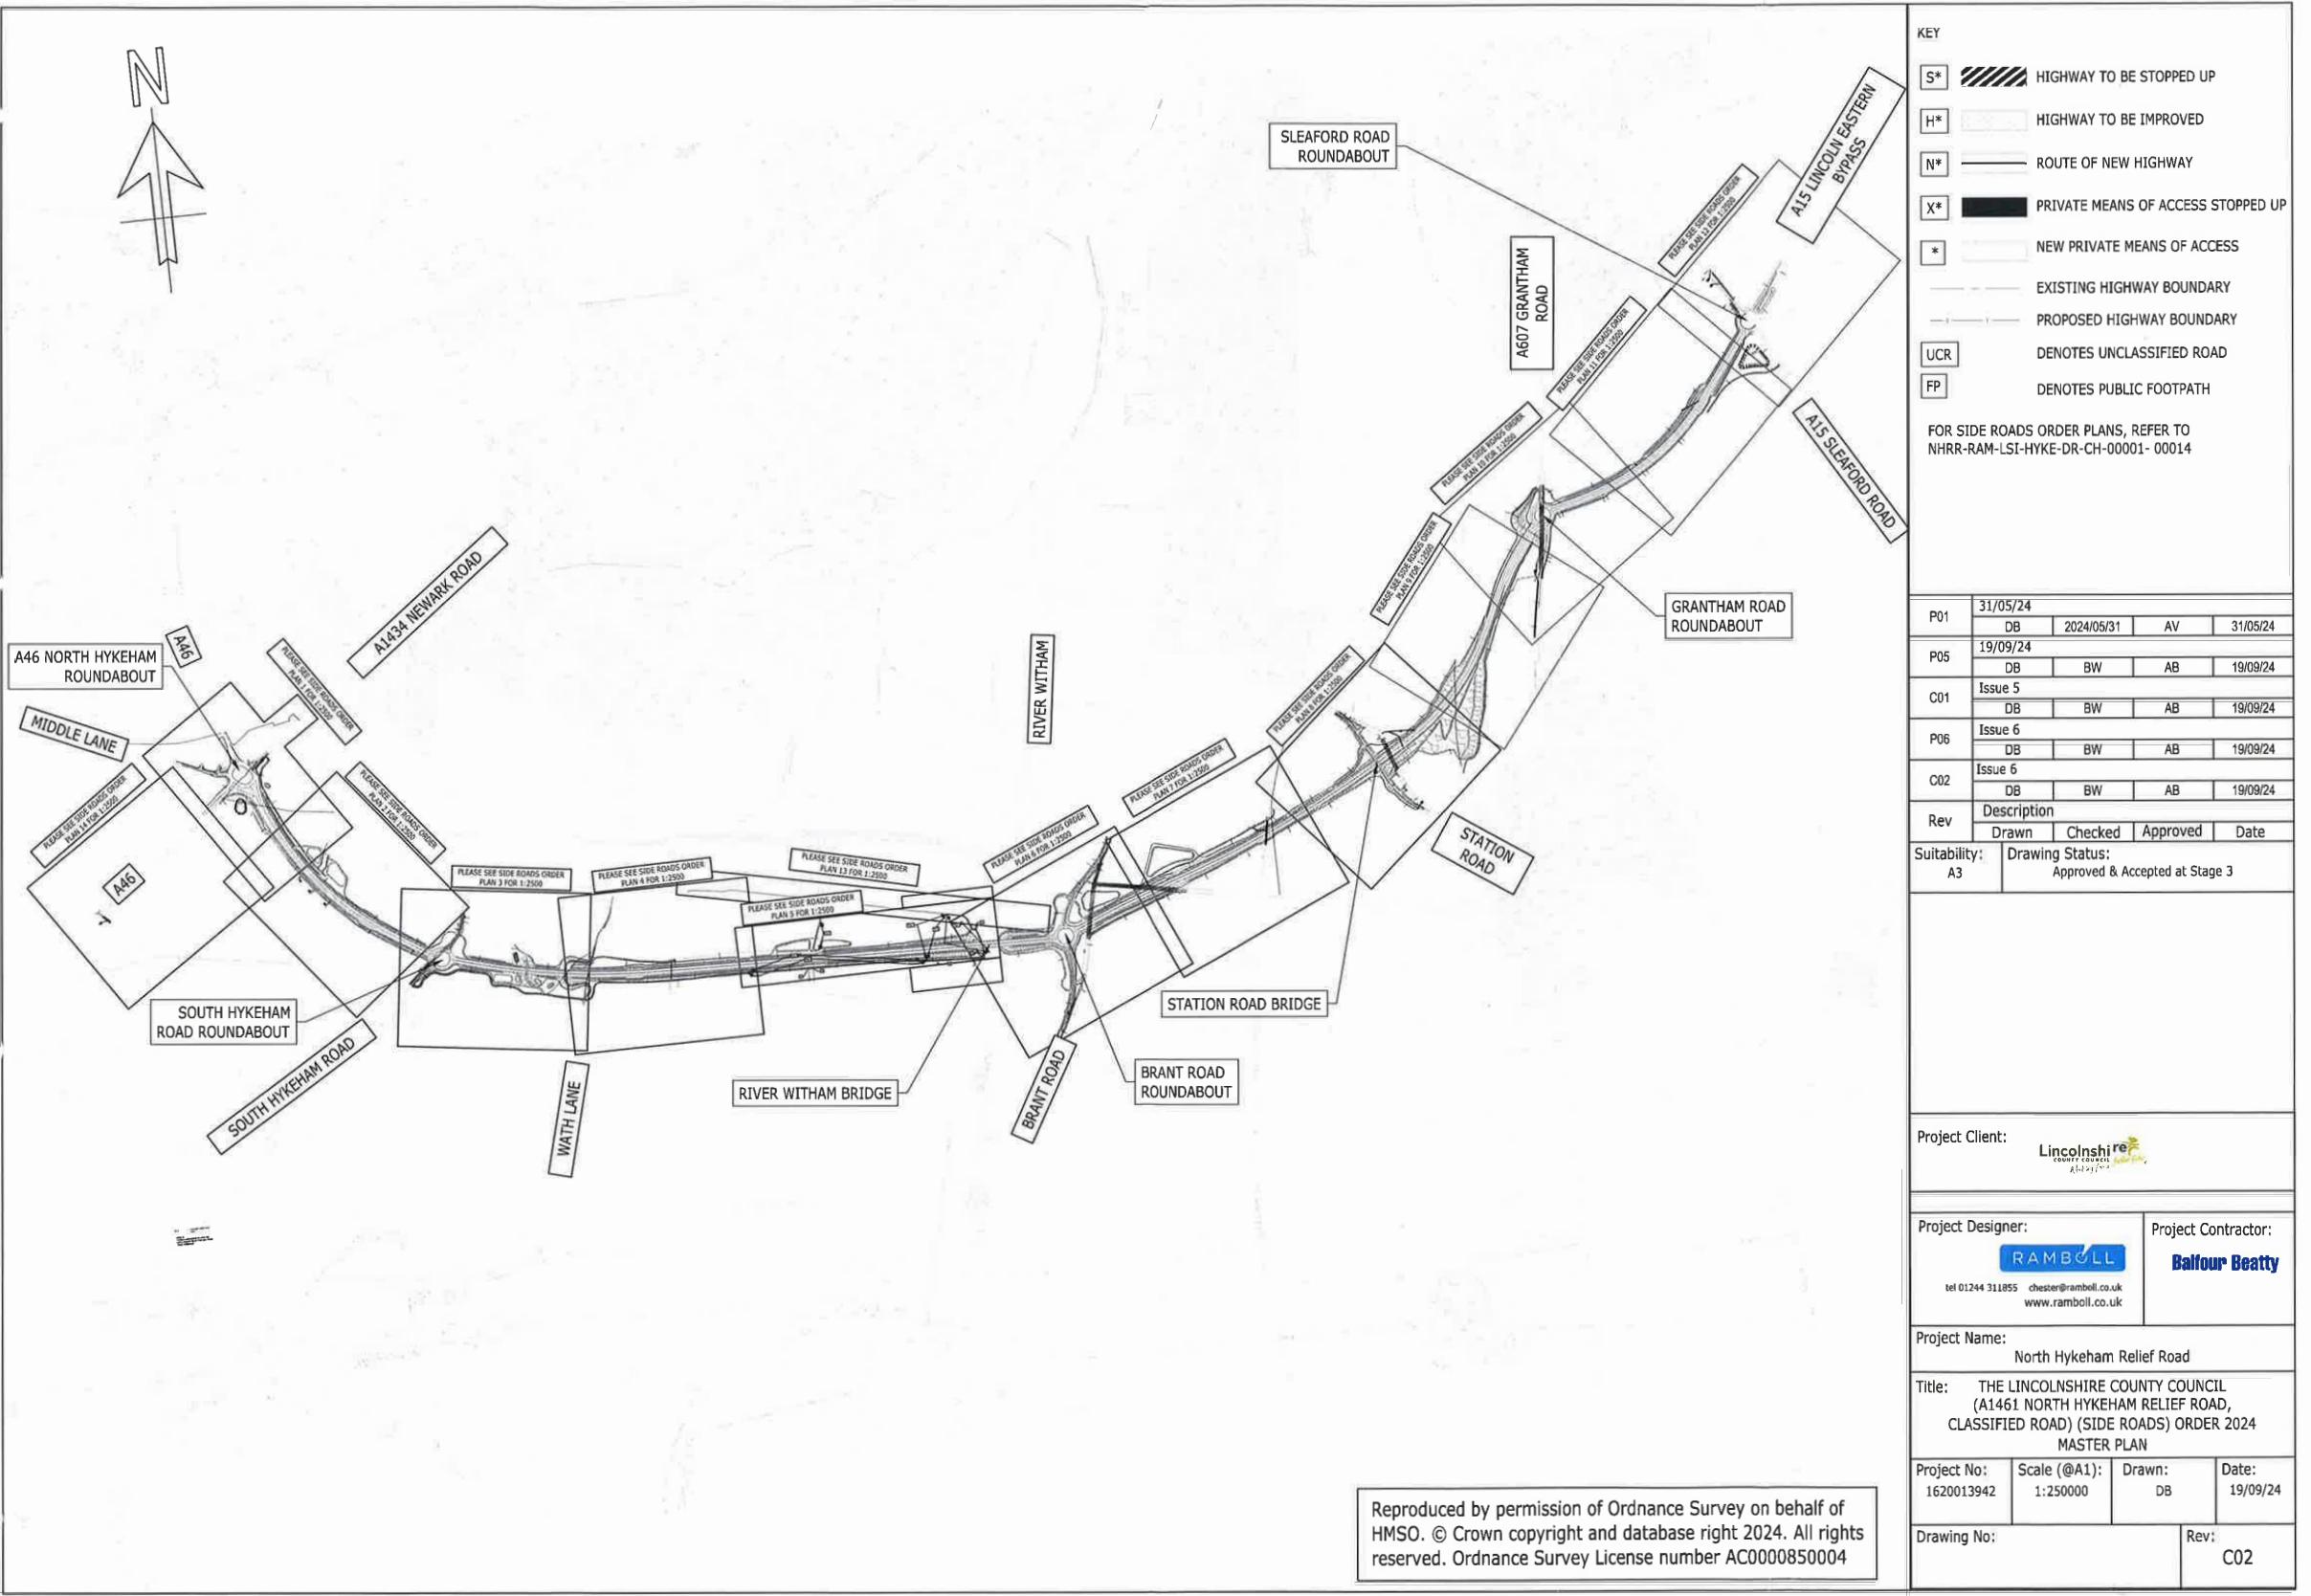





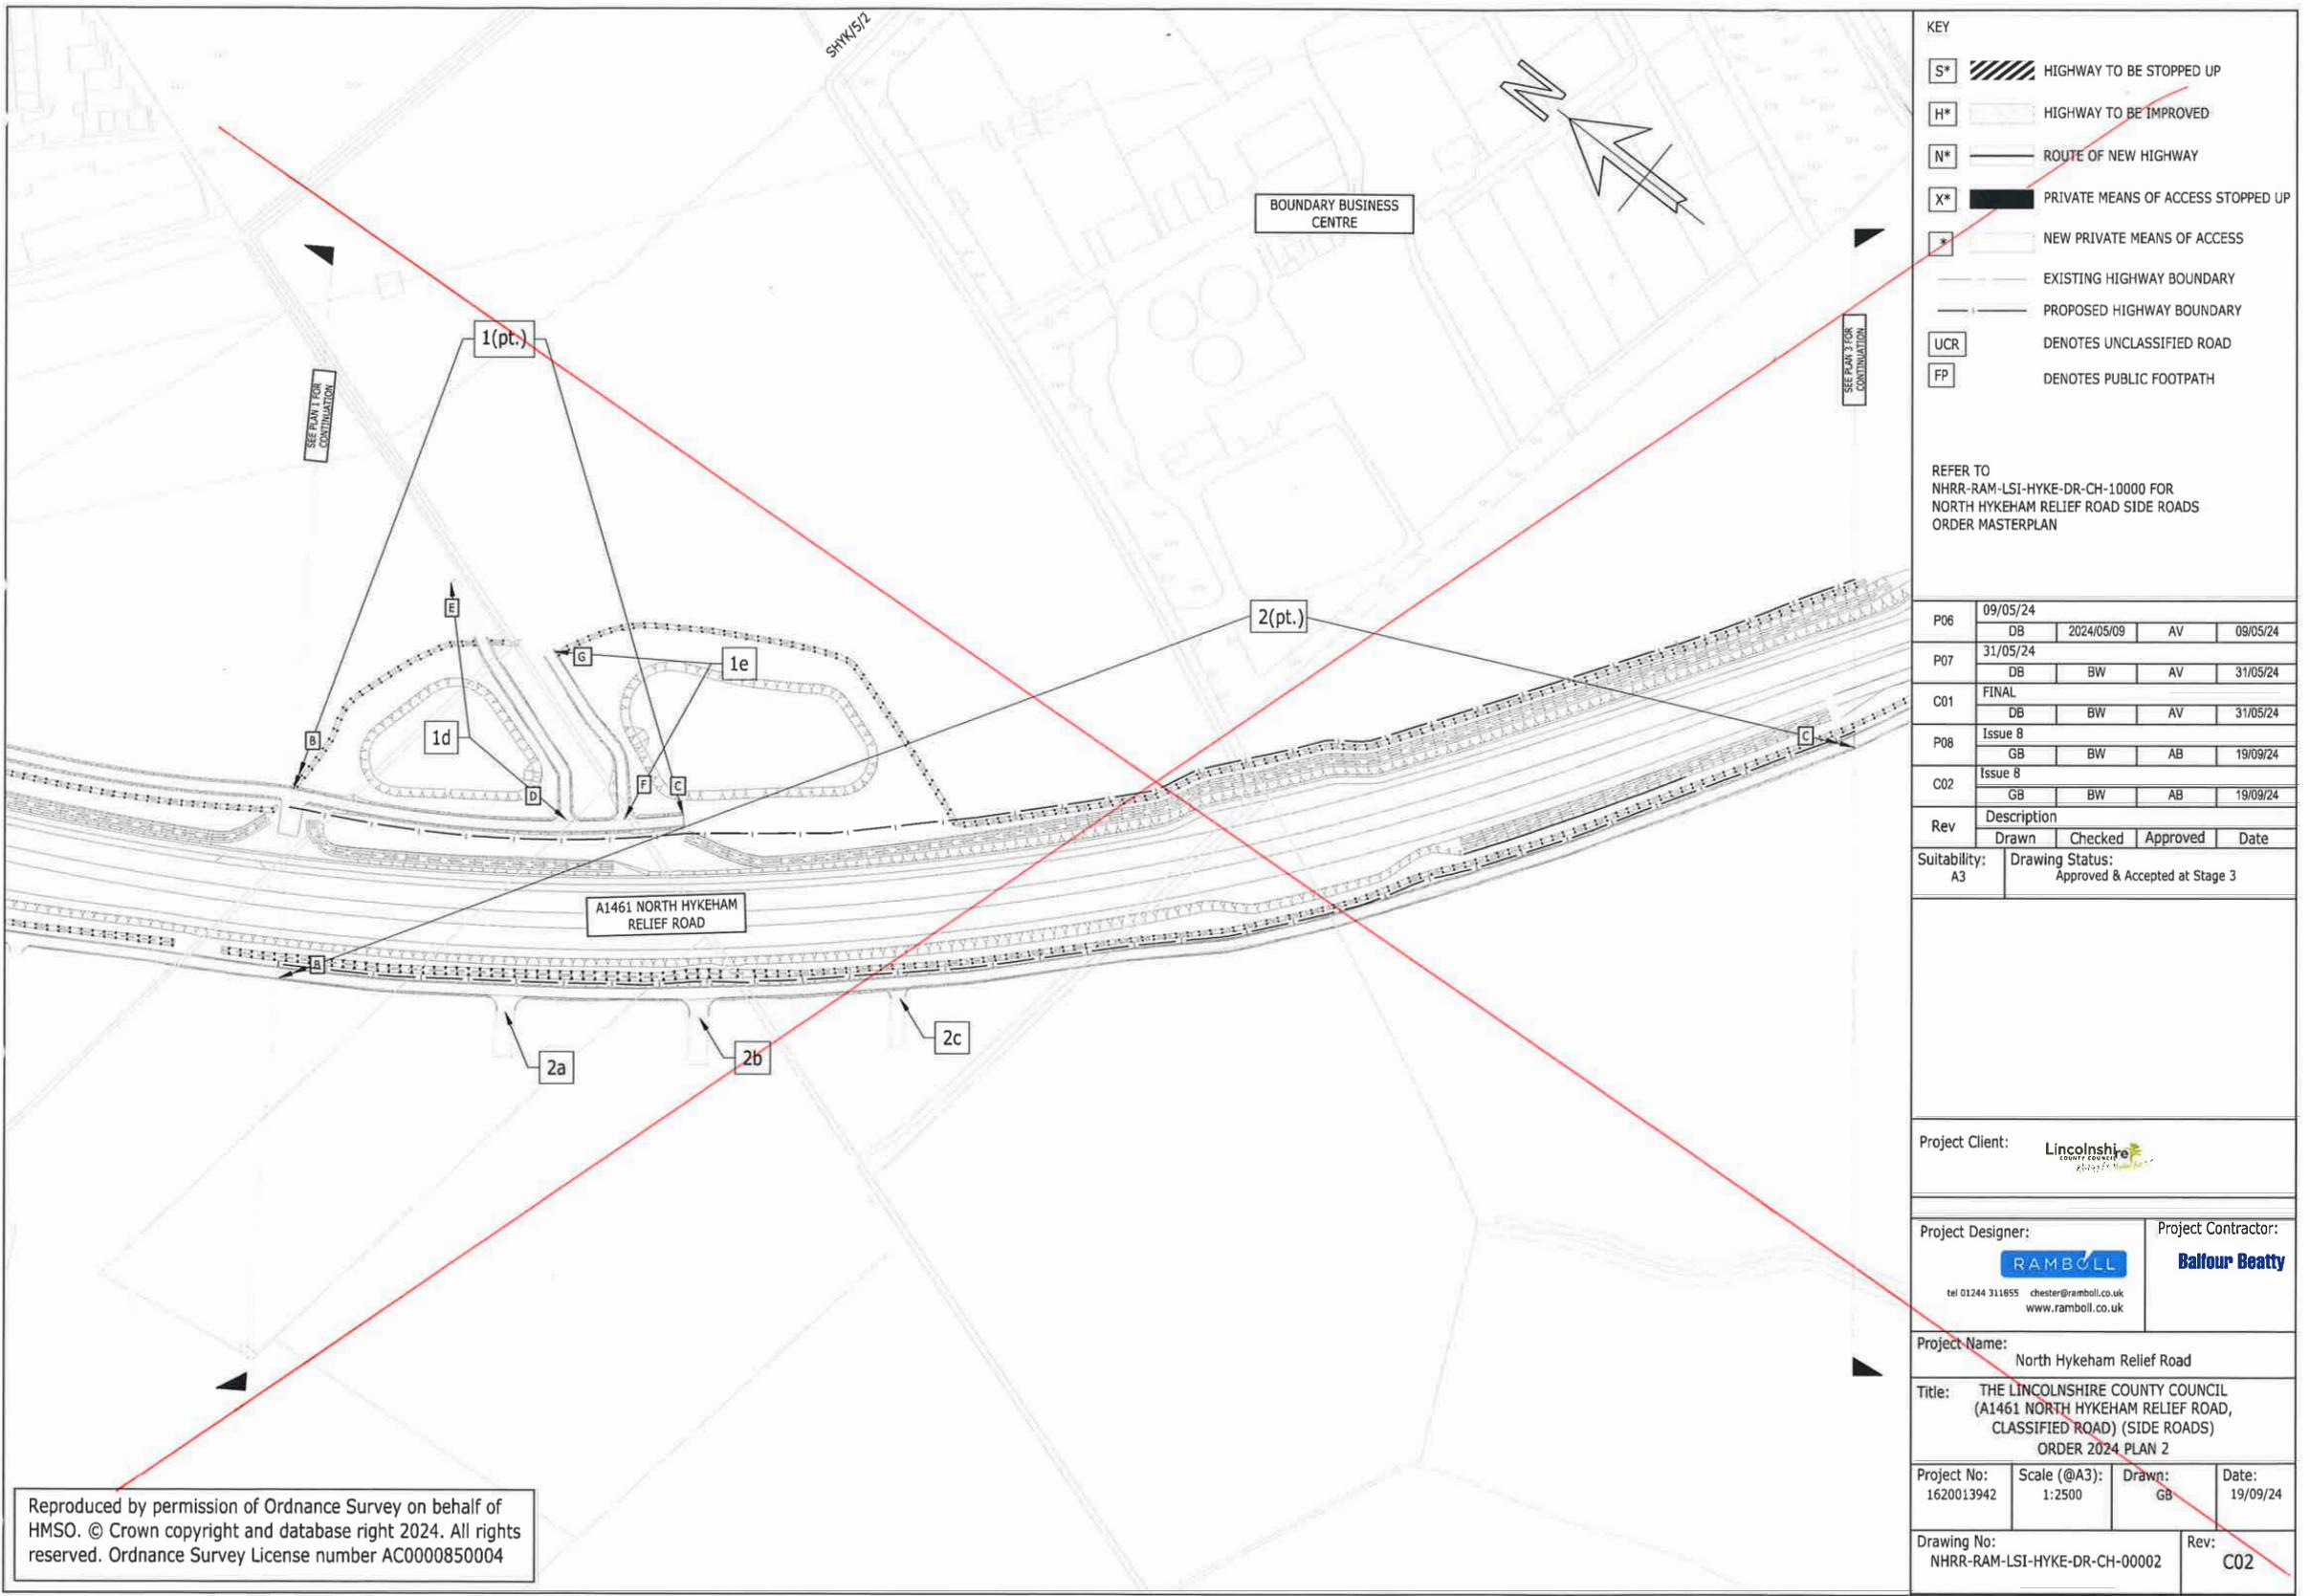


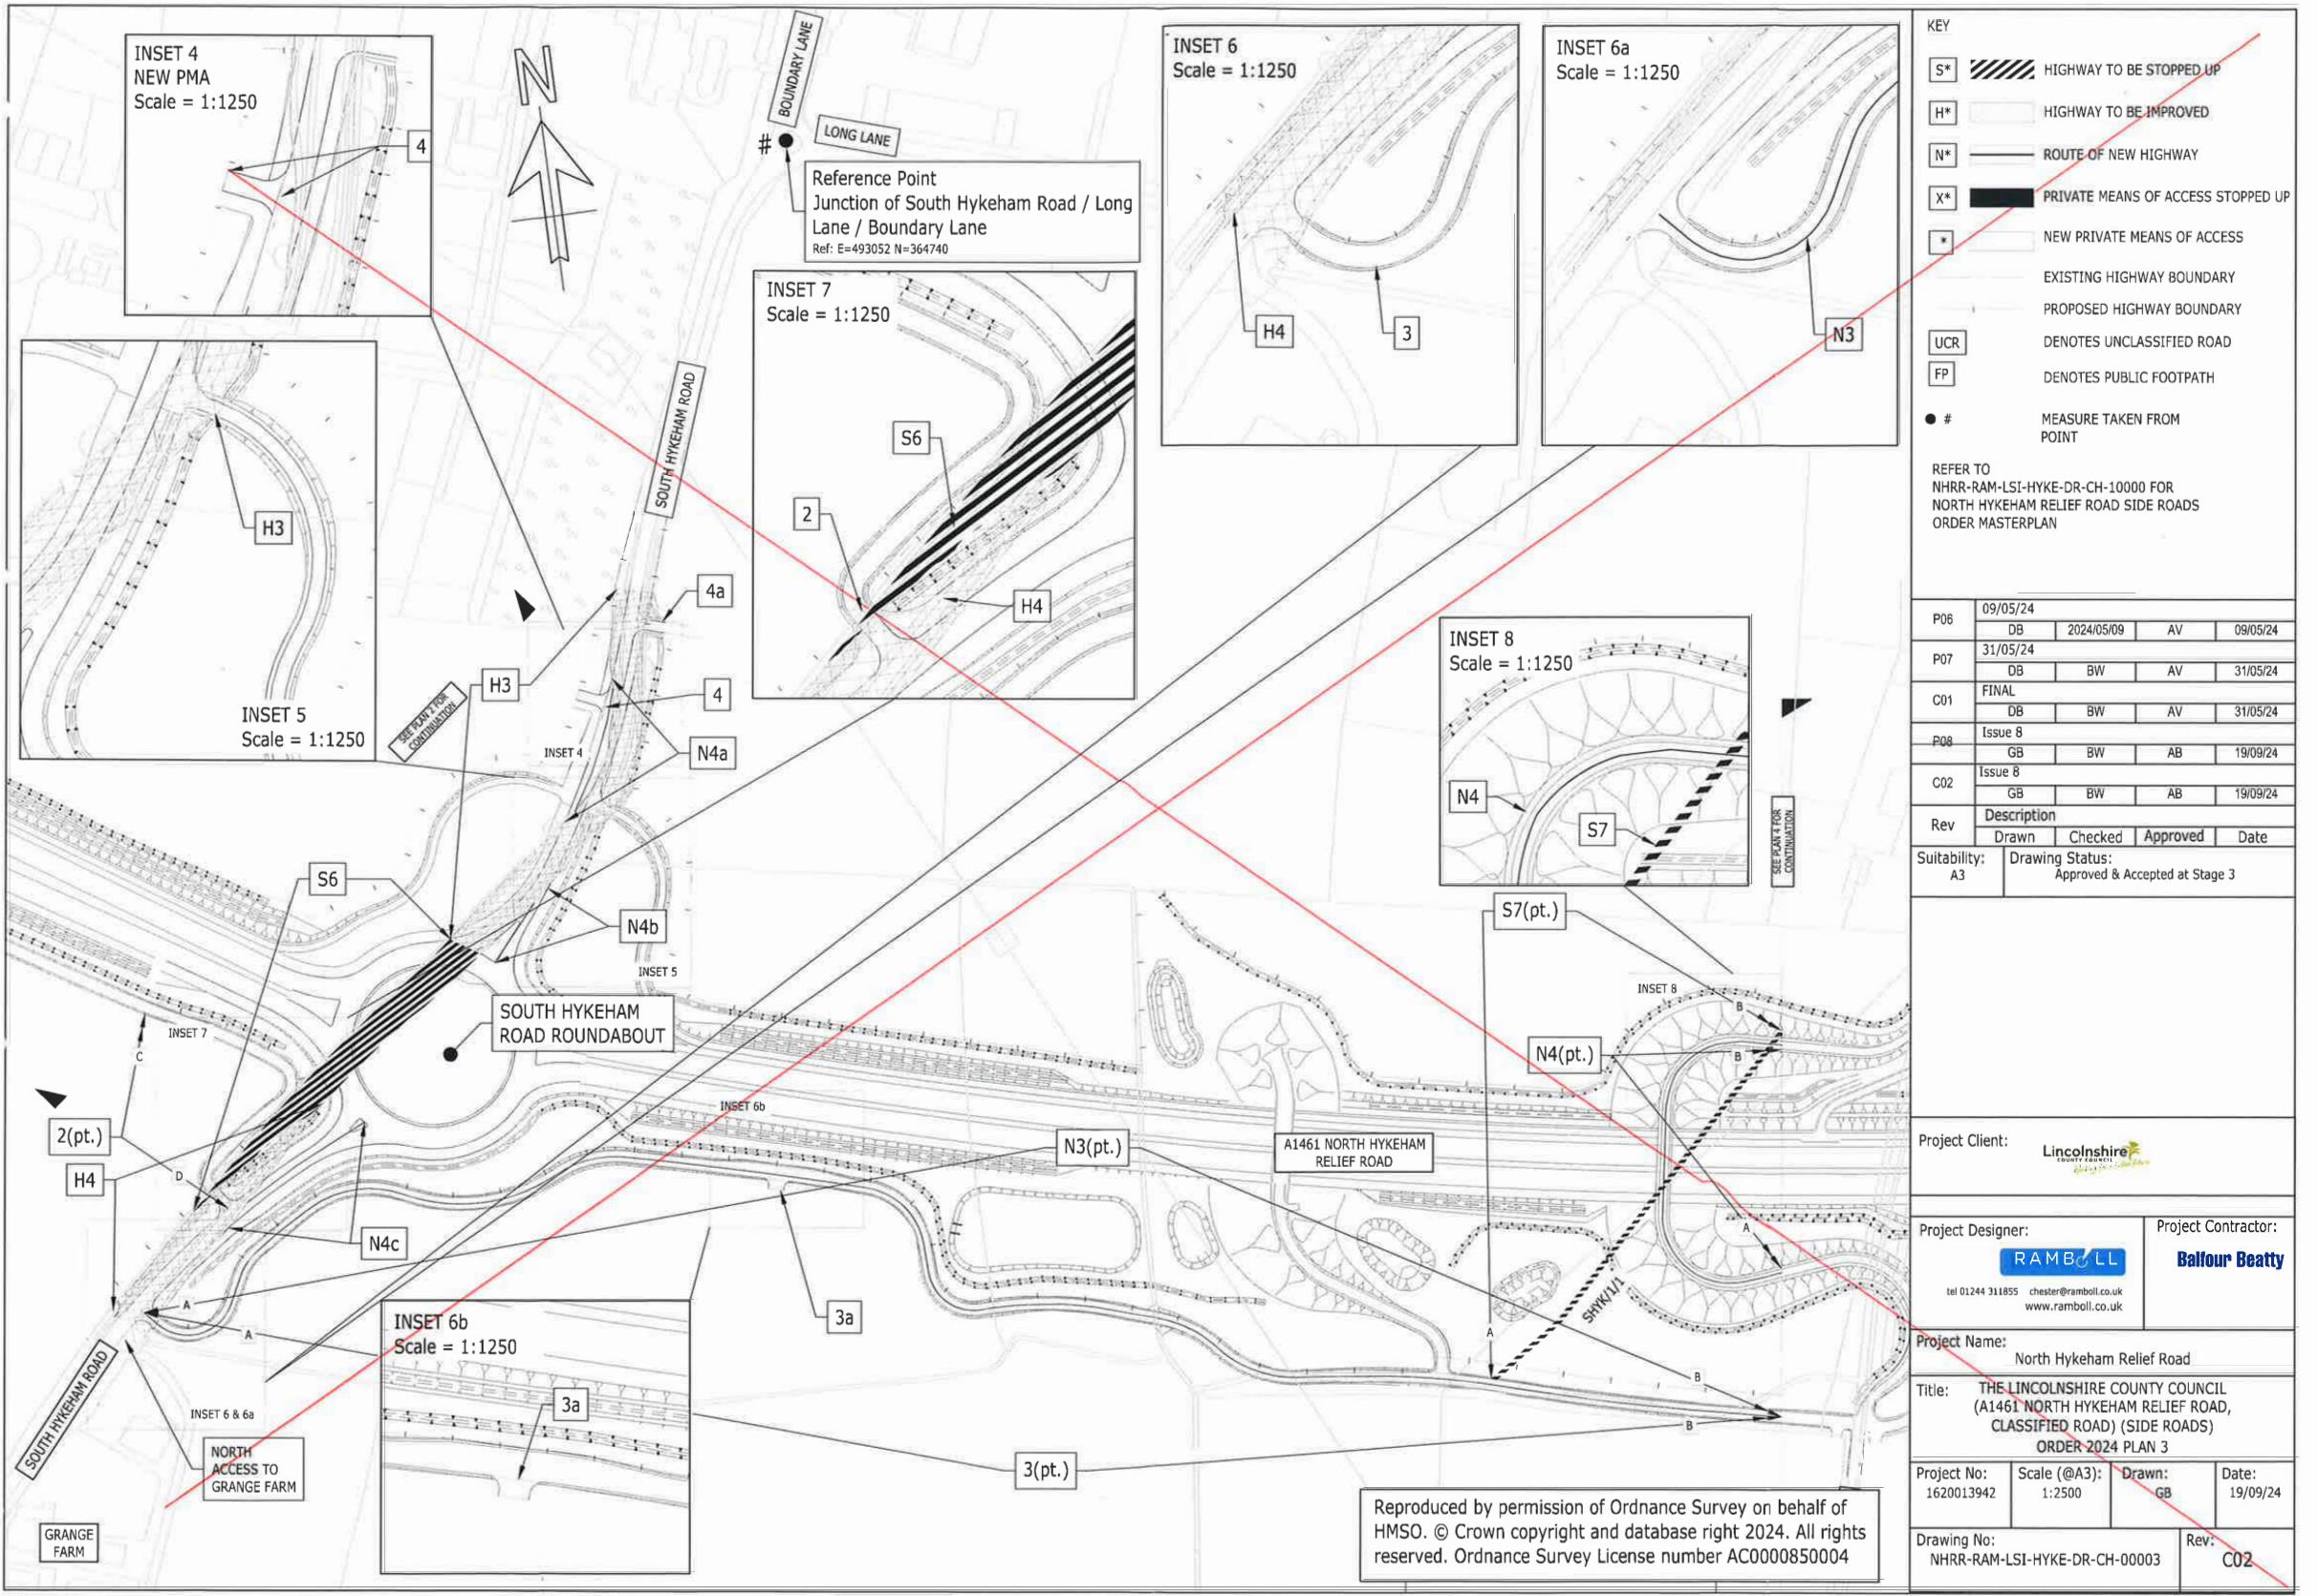


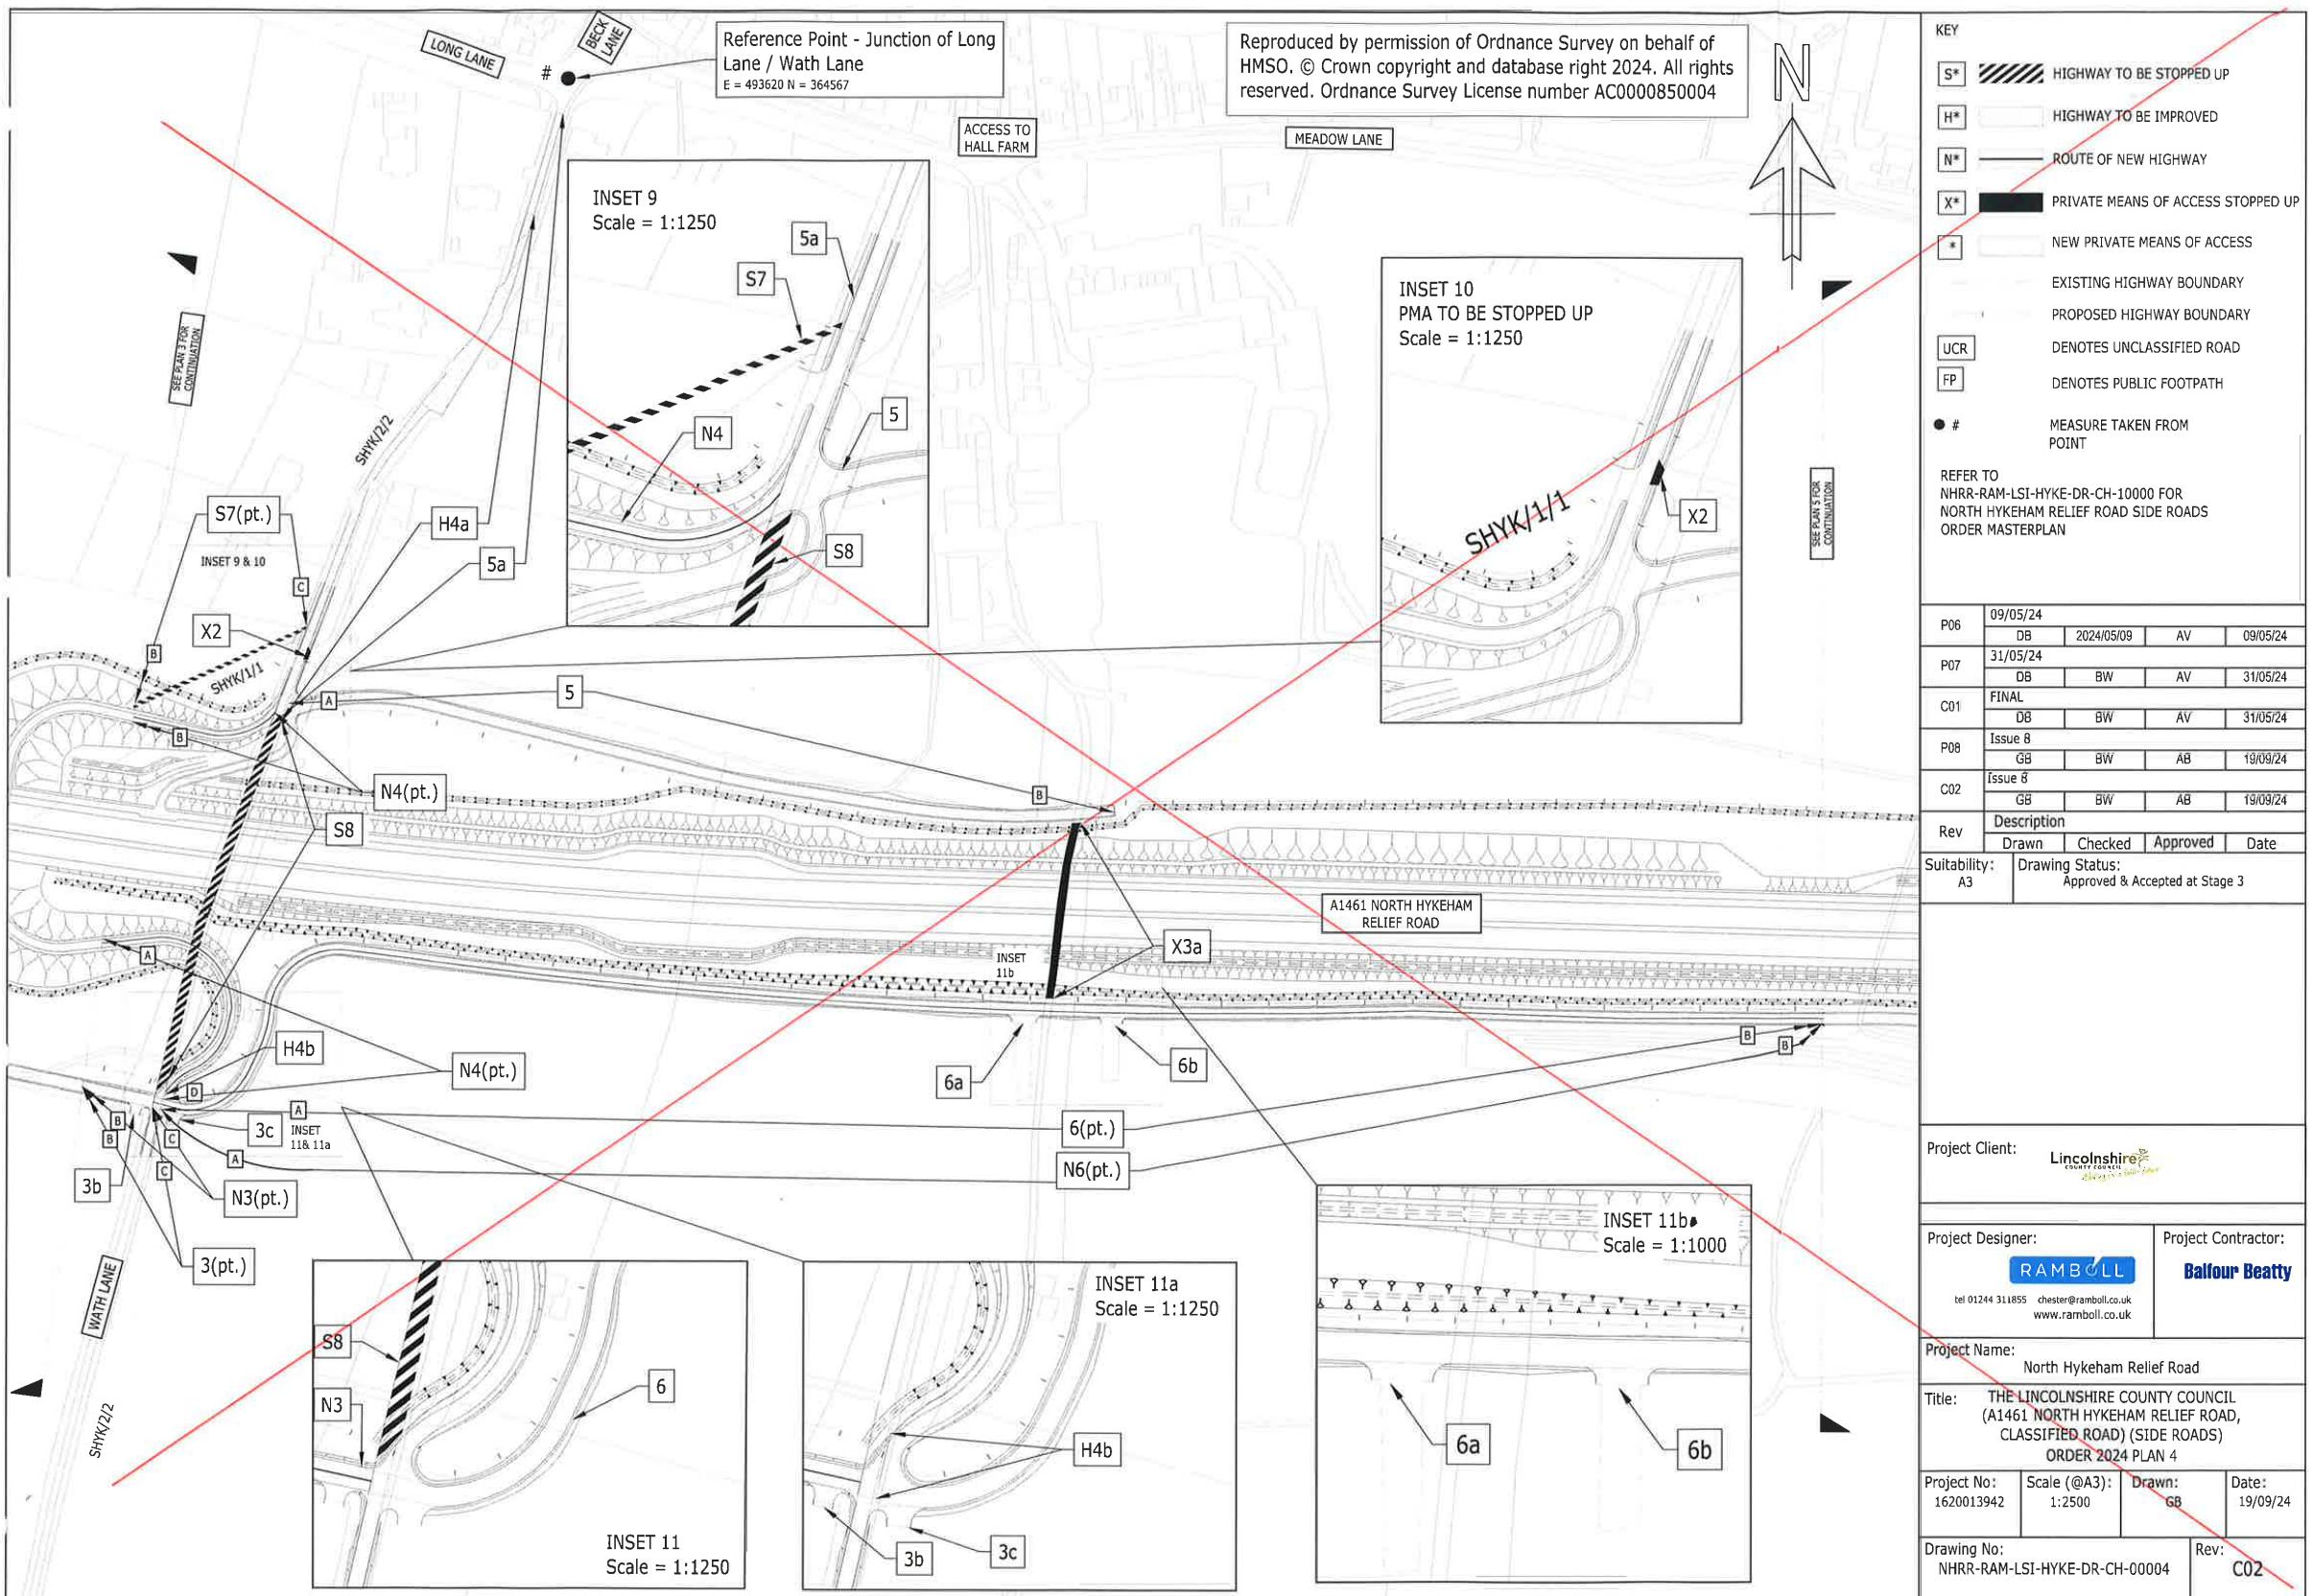



Reproduced by permission of Ordnance Survey on behalf of HMSO. © Crown copyright and database right 2024. All rights reserved. Ordnance Survey License number AC0000850004

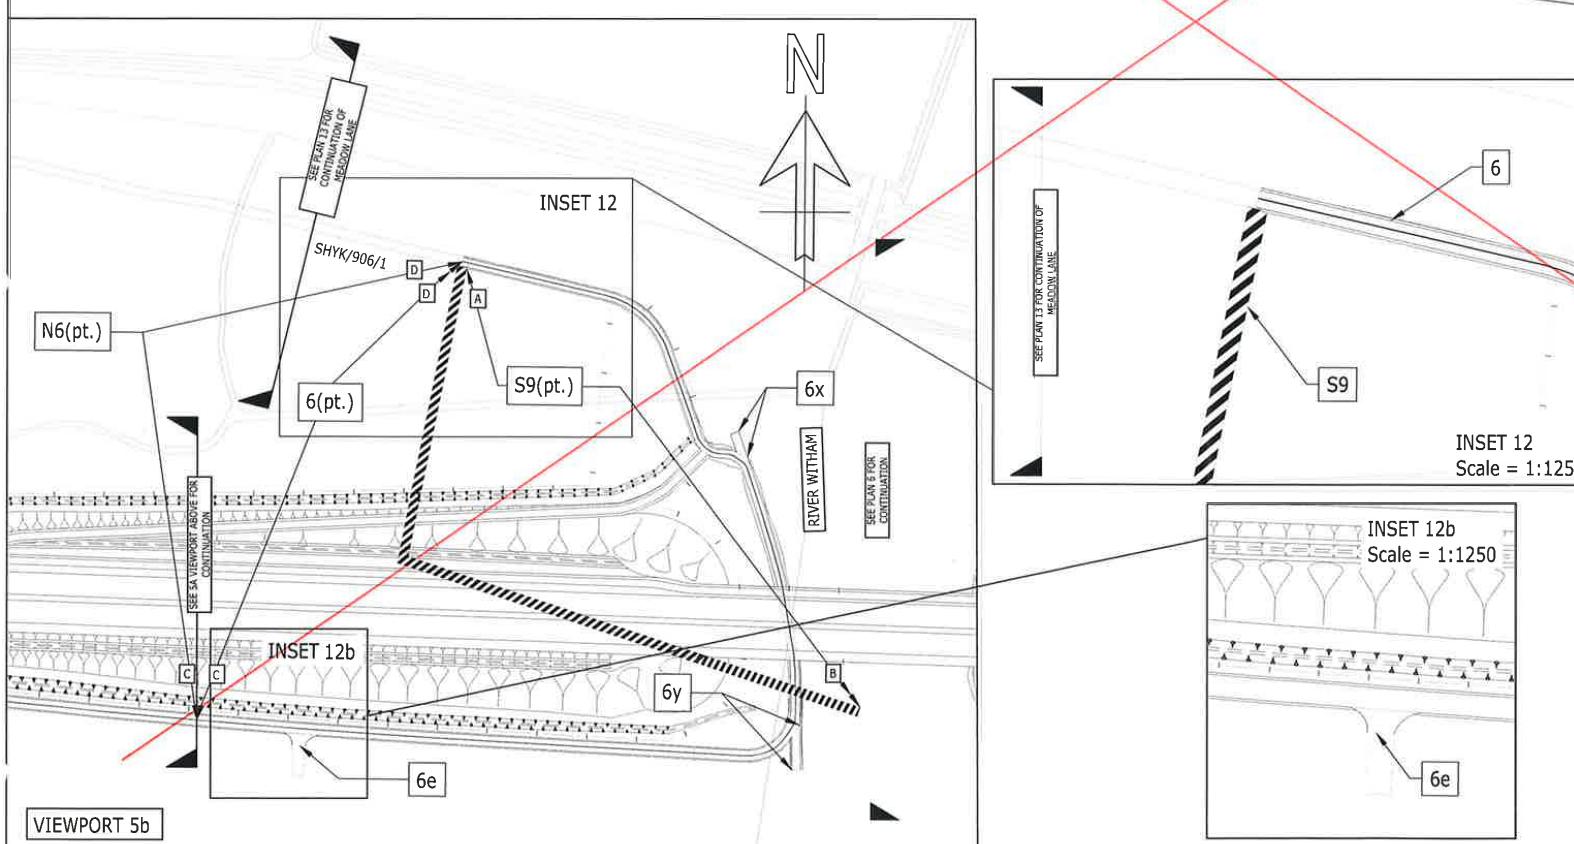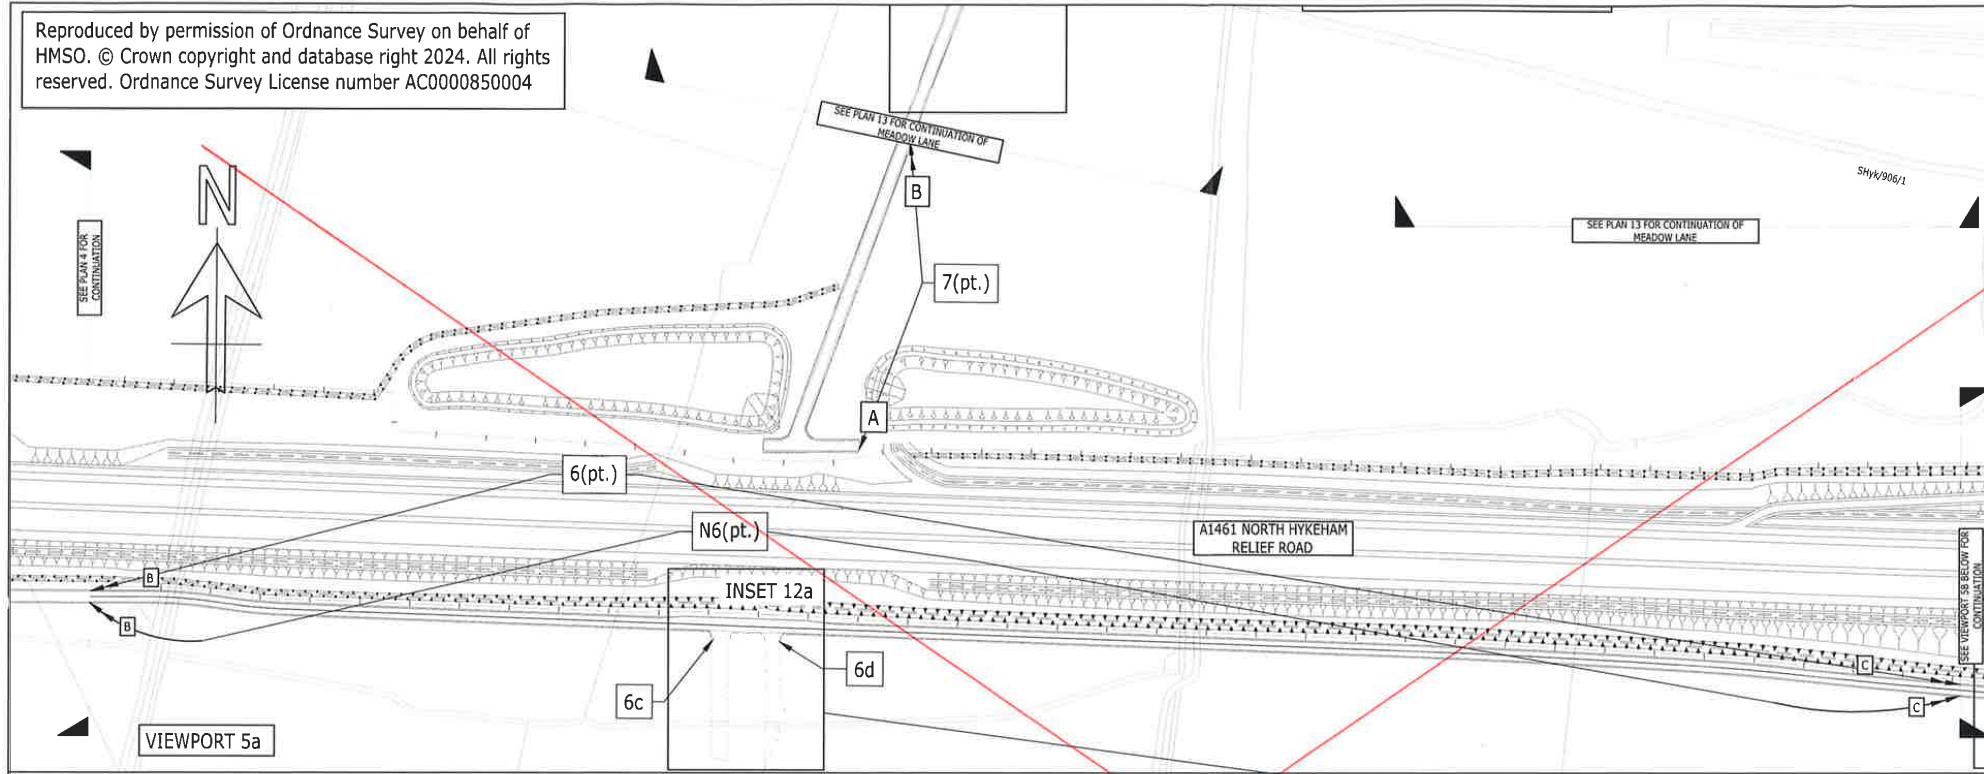


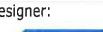
KEY																																																																		
<input type="checkbox"/> S*	HIGHWAY TO BE STOPPED UP																																																																	
<input type="checkbox"/> H*	HIGHWAY TO BE IMPROVED																																																																	
<input type="checkbox"/> N*	ROUTE OF NEW HIGHWAY																																																																	
<input type="checkbox"/> X*	PRIVATE MEANS OF ACCESS STOPPED UP																																																																	
<input type="checkbox"/> *	NEW PRIVATE MEANS OF ACCESS																																																																	
<input type="checkbox"/> —	EXISTING HIGHWAY BOUNDARY																																																																	
<input type="checkbox"/> - - -	PROPOSED HIGHWAY BOUNDARY																																																																	
<input type="checkbox"/> UCR	DENOTES UNCLASSIFIED ROAD																																																																	
<input type="checkbox"/> FP	DENOTES PUBLIC FOOTPATH																																																																	
<input checked="" type="radio"/> #	MEASURE TAKEN FROM POINT																																																																	
<p>REFER TO            NHRR-RAM-LSI-HYKE-DR-CH-10000 FOR            NORTH HYKEHAM RELIEF ROAD SIDE ROADS            ORDER MASTERPLAN</p>																																																																		
<table border="1"> <tr> <td>C01</td> <td colspan="4">31/05/24</td> </tr> <tr> <td></td> <td>DB</td> <td>2024/05/31</td> <td>AV</td> <td>31/05/24</td> </tr> <tr> <td>P08</td> <td colspan="4">15/08/24</td> </tr> <tr> <td></td> <td>BC</td> <td>BW</td> <td>AV</td> <td>15/08/24</td> </tr> <tr> <td>C02</td> <td colspan="4">Issue 8</td> </tr> <tr> <td></td> <td>BC</td> <td>BW</td> <td>AV</td> <td>15/08/24</td> </tr> <tr> <td>P09</td> <td colspan="4">Issue 9</td> </tr> <tr> <td></td> <td>GB</td> <td>BW</td> <td>AB</td> <td>19/09/24</td> </tr> <tr> <td>C03</td> <td colspan="4">Issue 9</td> </tr> <tr> <td></td> <td>GB</td> <td>BW</td> <td>AB</td> <td>19/09/24</td> </tr> <tr> <td>Rev</td> <td colspan="4">Description</td> </tr> <tr> <td></td> <td>Drawn</td> <td>Checked</td> <td>Approved</td> <td>Date</td> </tr> <tr> <td>Suitability: A3</td> <td colspan="4">Drawing Status: Approved &amp; Accepted at Stage 3</td> </tr> </table>		C01	31/05/24					DB	2024/05/31	AV	31/05/24	P08	15/08/24					BC	BW	AV	15/08/24	C02	Issue 8					BC	BW	AV	15/08/24	P09	Issue 9					GB	BW	AB	19/09/24	C03	Issue 9					GB	BW	AB	19/09/24	Rev	Description					Drawn	Checked	Approved	Date	Suitability: A3	Drawing Status: Approved & Accepted at Stage 3			
C01	31/05/24																																																																	
	DB	2024/05/31	AV	31/05/24																																																														
P08	15/08/24																																																																	
	BC	BW	AV	15/08/24																																																														
C02	Issue 8																																																																	
	BC	BW	AV	15/08/24																																																														
P09	Issue 9																																																																	
	GB	BW	AB	19/09/24																																																														
C03	Issue 9																																																																	
	GB	BW	AB	19/09/24																																																														
Rev	Description																																																																	
	Drawn	Checked	Approved	Date																																																														
Suitability: A3	Drawing Status: Approved & Accepted at Stage 3																																																																	
<p>Project Client: </p>																																																																		
<p>Project Designer: </p>																																																																		
<p>tel 01244 311855 <a href="mailto:chester@ramboll.co.uk">chester@ramboll.co.uk</a>  <a href="http://www.ramboll.co.uk">www.ramboll.co.uk</a></p>																																																																		
<p>Project Contractor: </p>																																																																		
<p>Project Name: North Hykeham Relief Road</p>																																																																		
<p>Title: THE LINCOLNSHIRE COUNTY COUNCIL            (A1461) NORTH HYKEHAM RELIEF ROAD,            CLASSIFIED ROAD) (SIDE ROADS)            ORDER 2024 PLAN 5</p>																																																																		
Project No: 1620013942	Scale (@A3): 1:2500	Drawn: GB	Date: 19/09/24																																																															
Drawing No: NHRR-RAM-LSI-HYKE-DR-CH-00005		Rev: C03																																																																

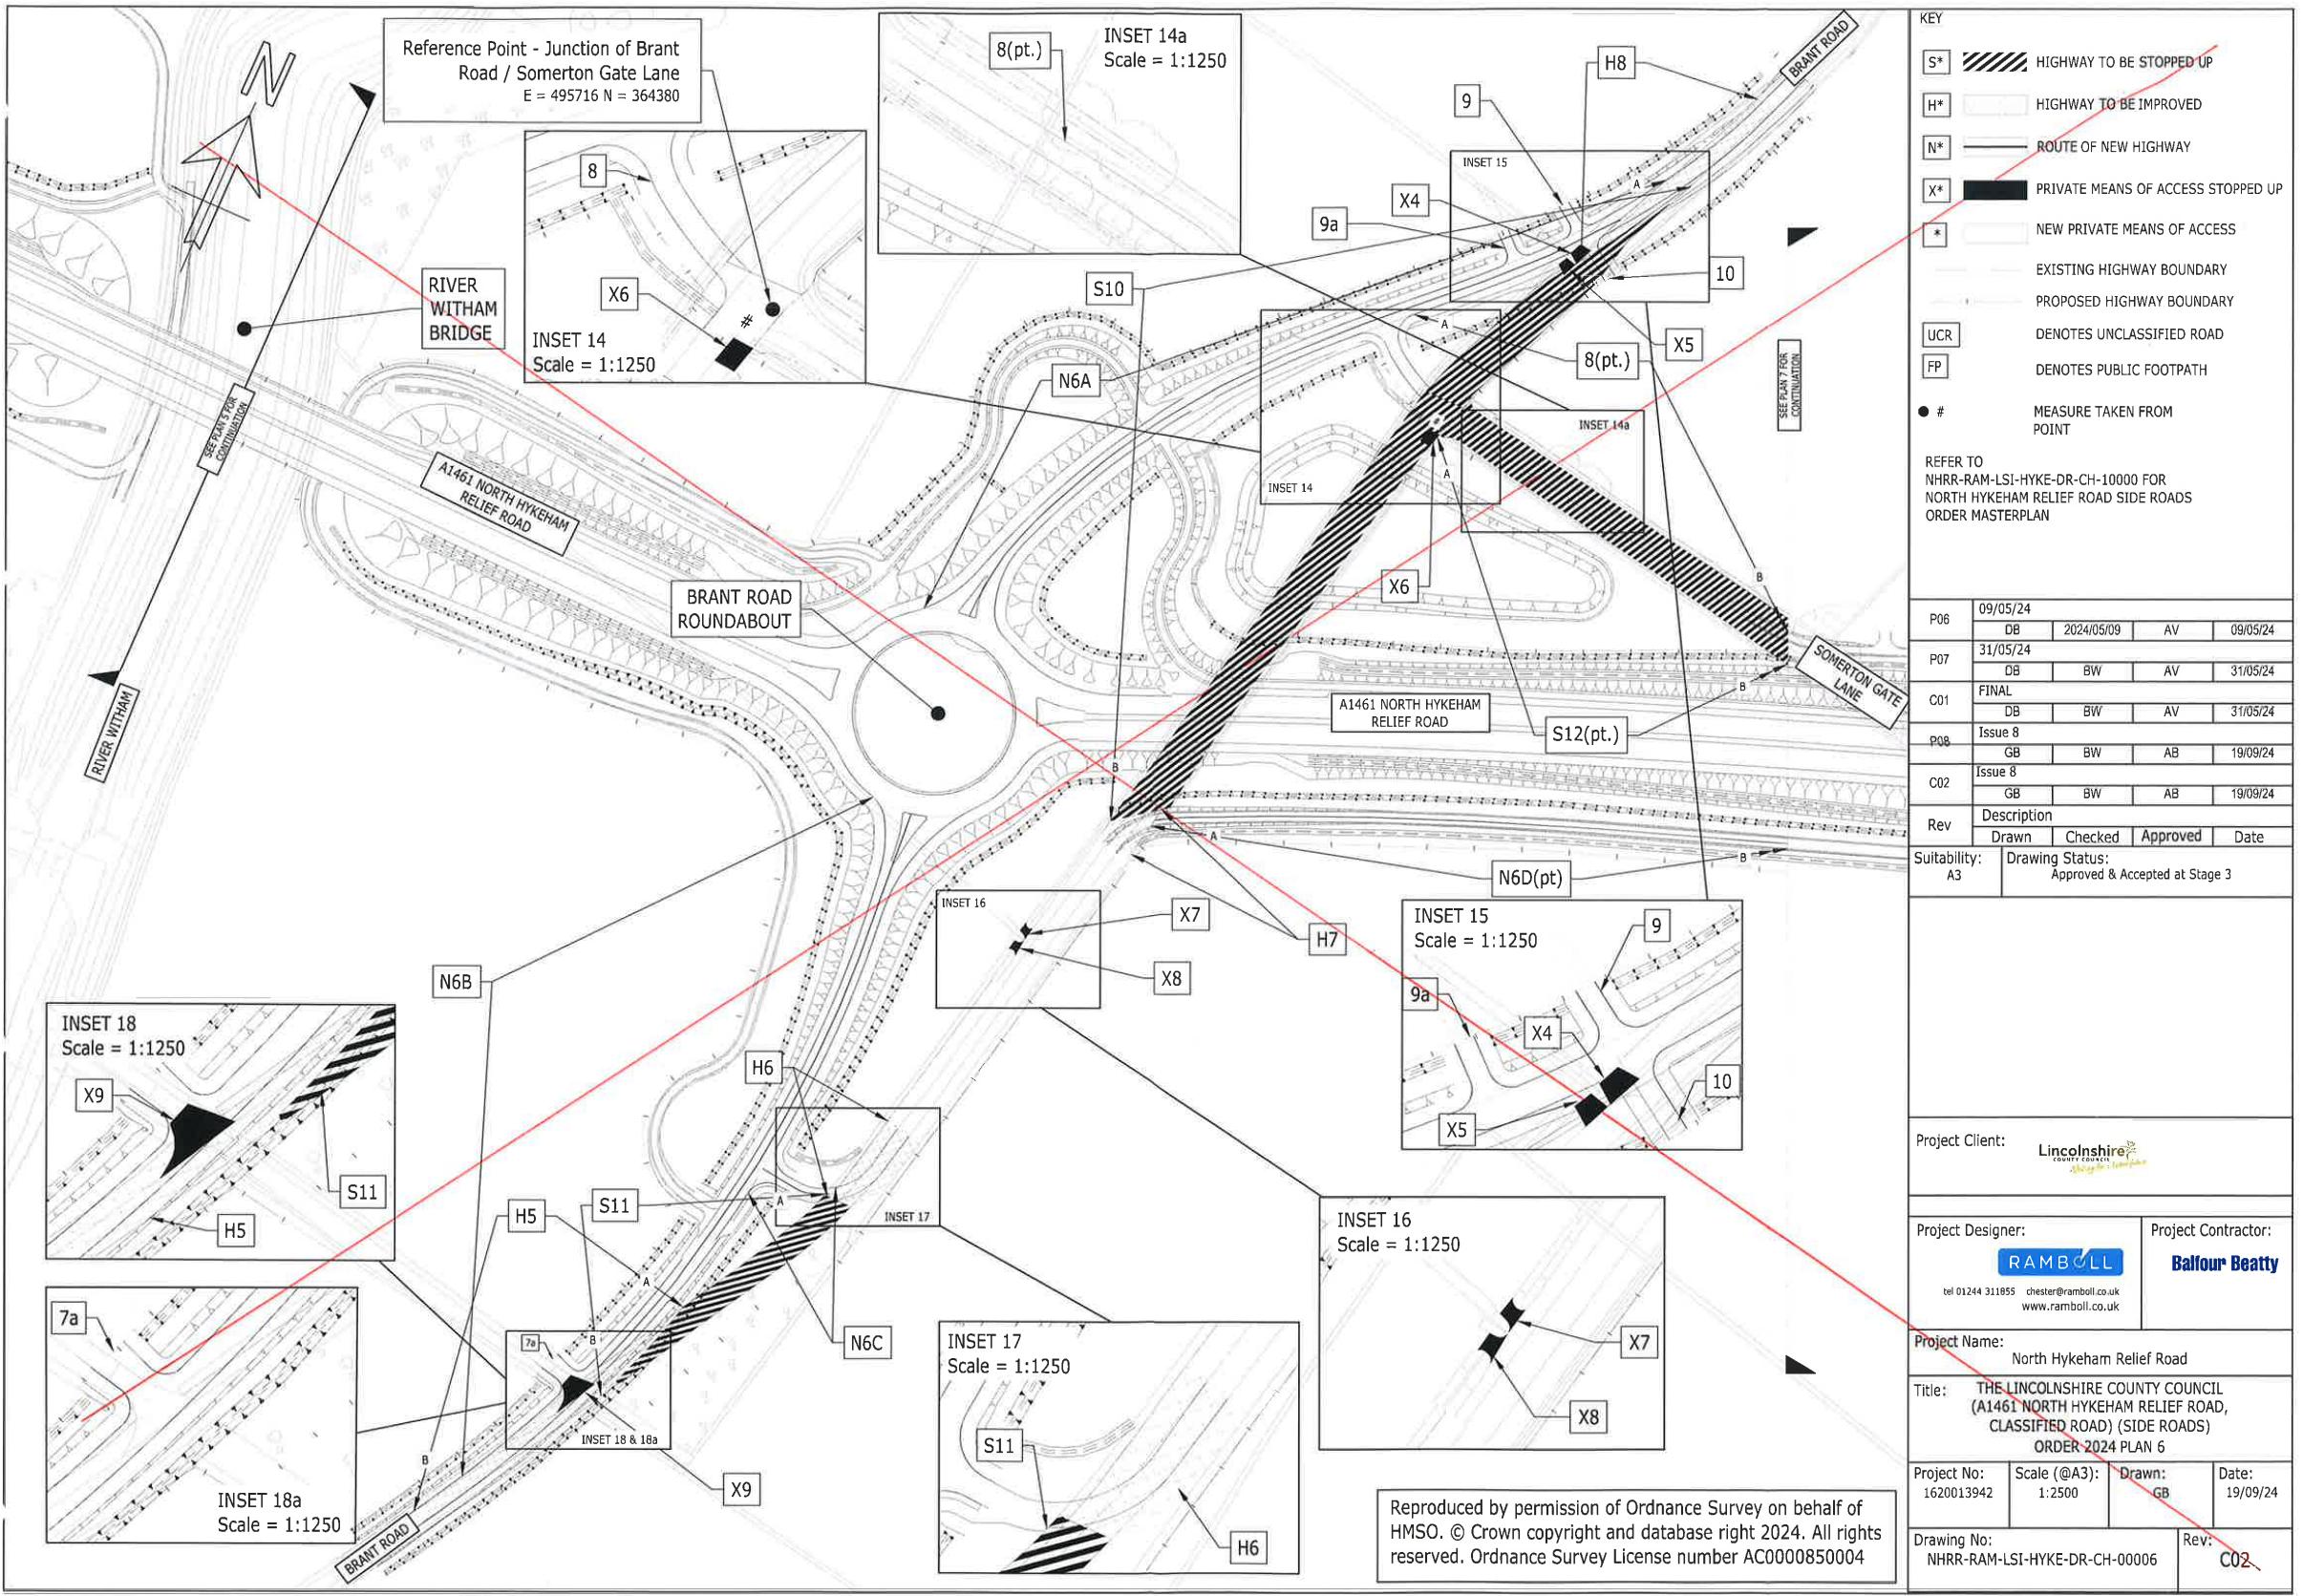


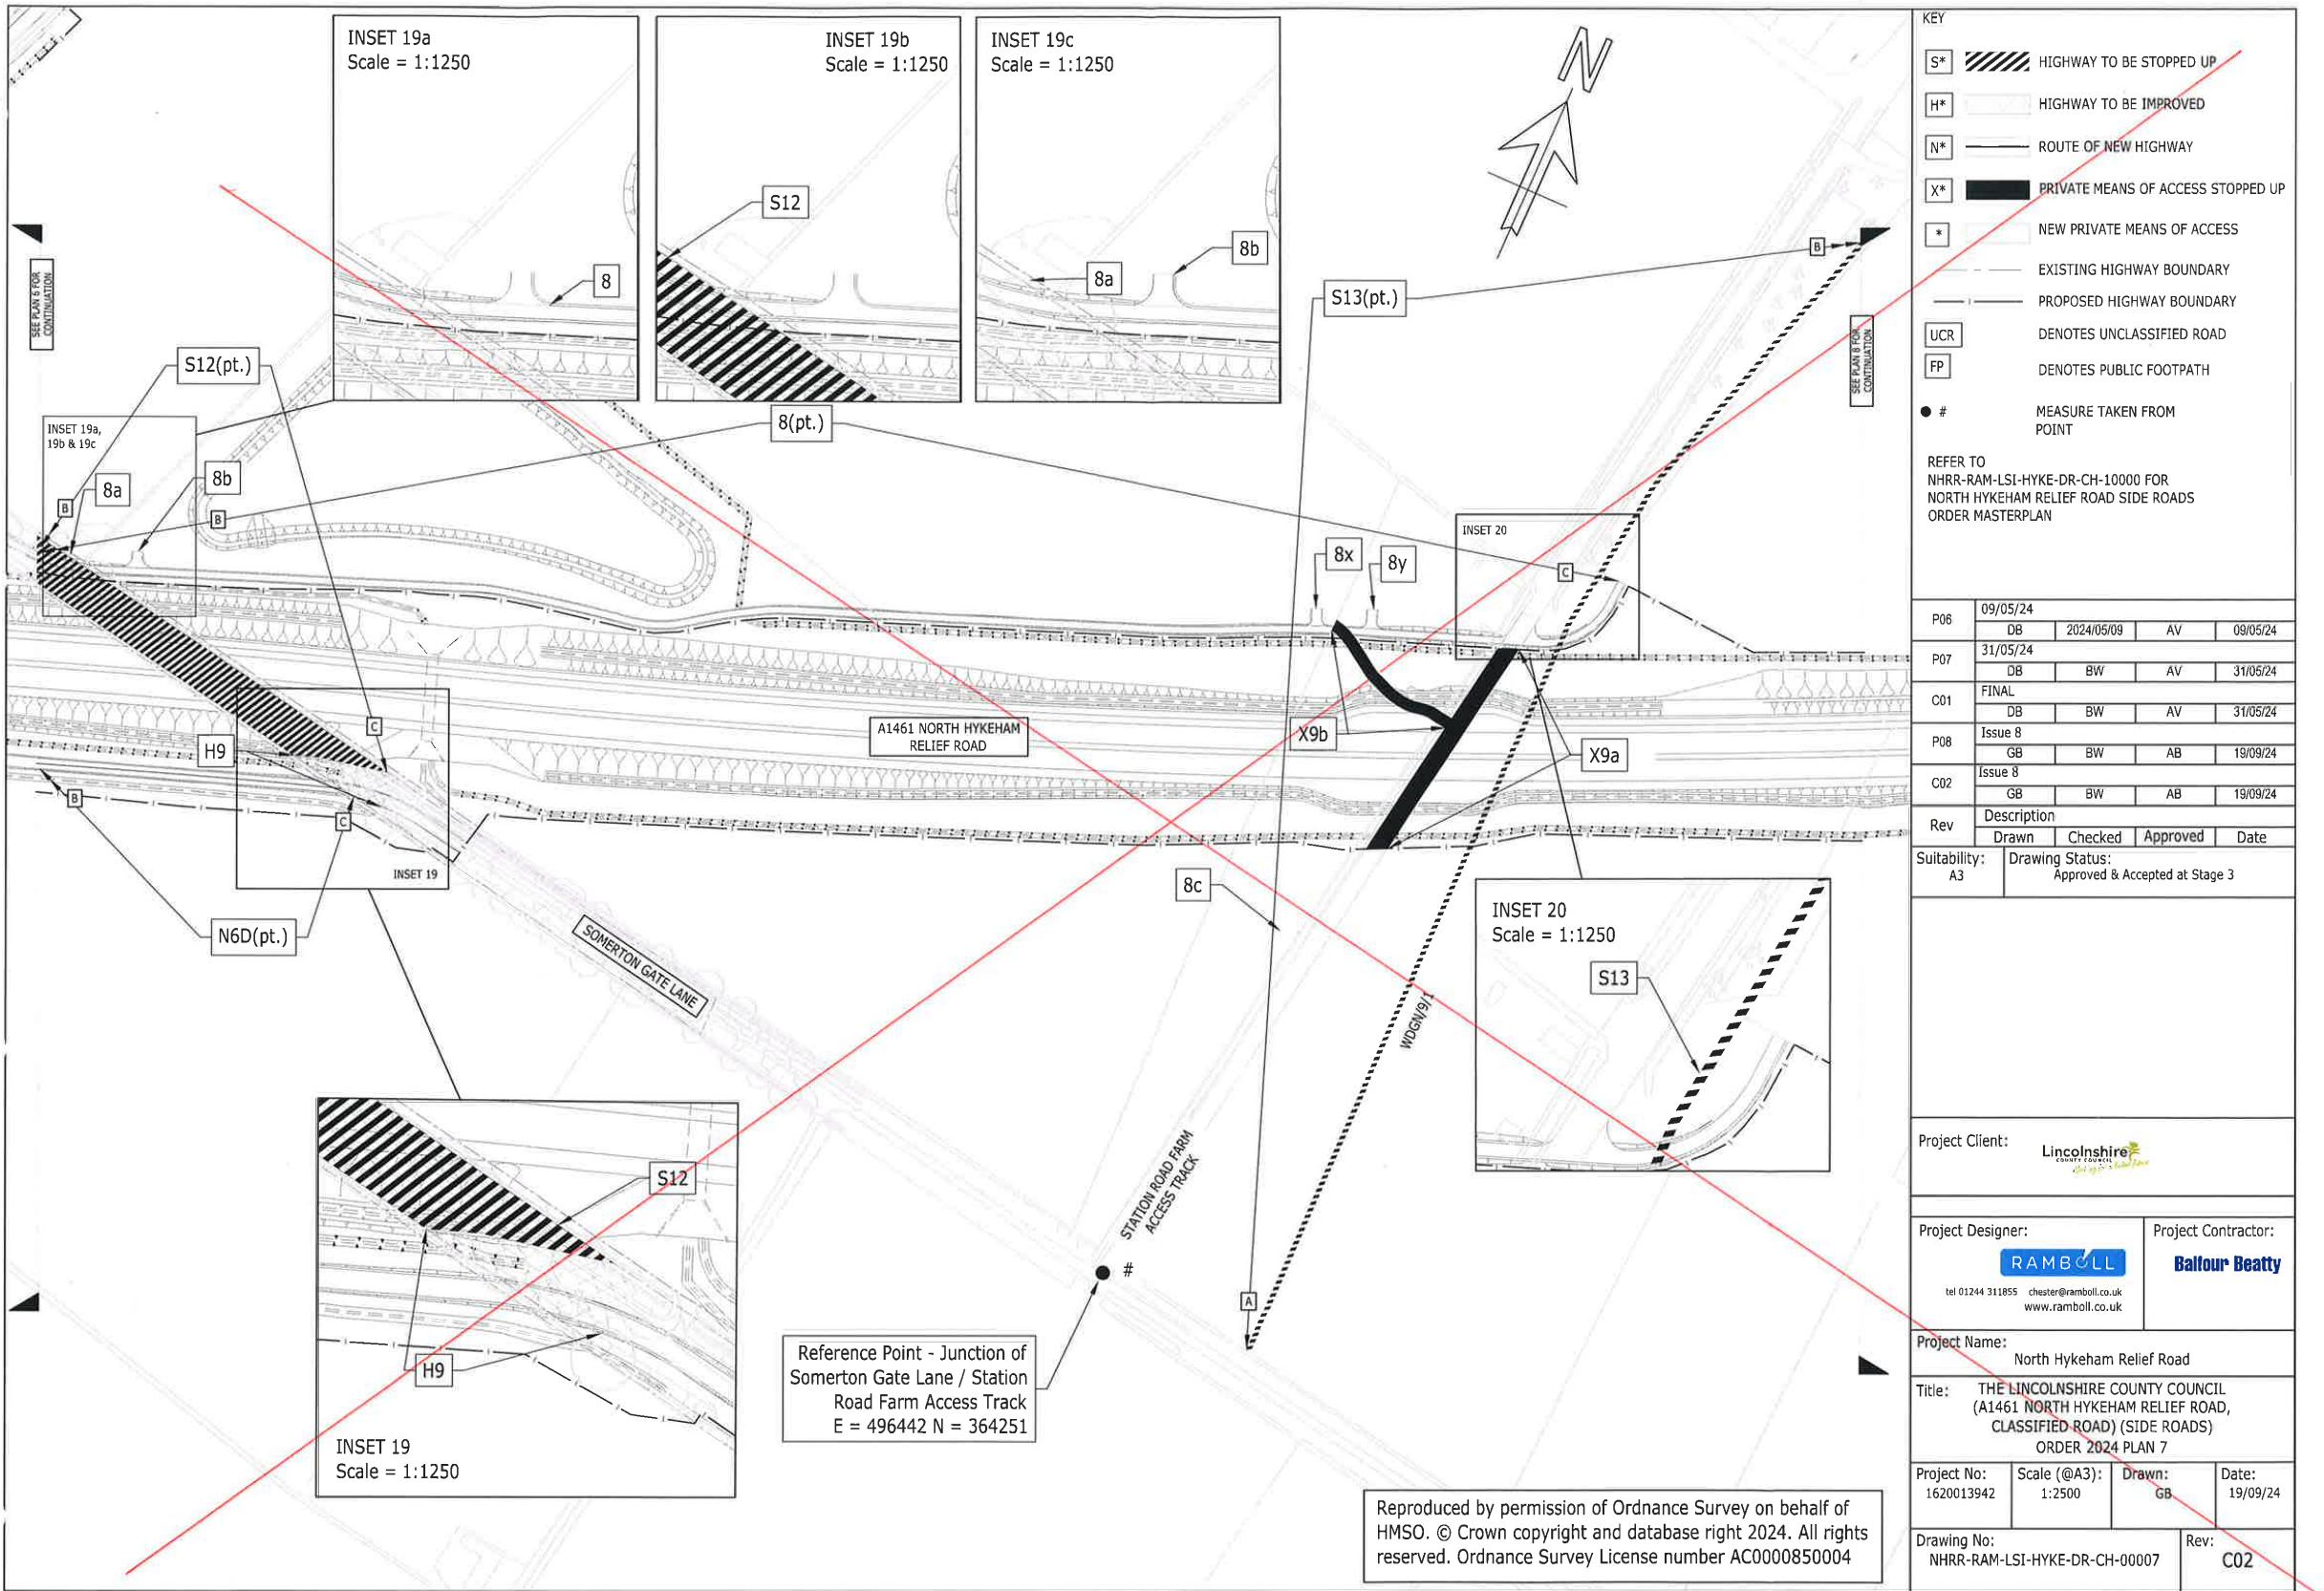


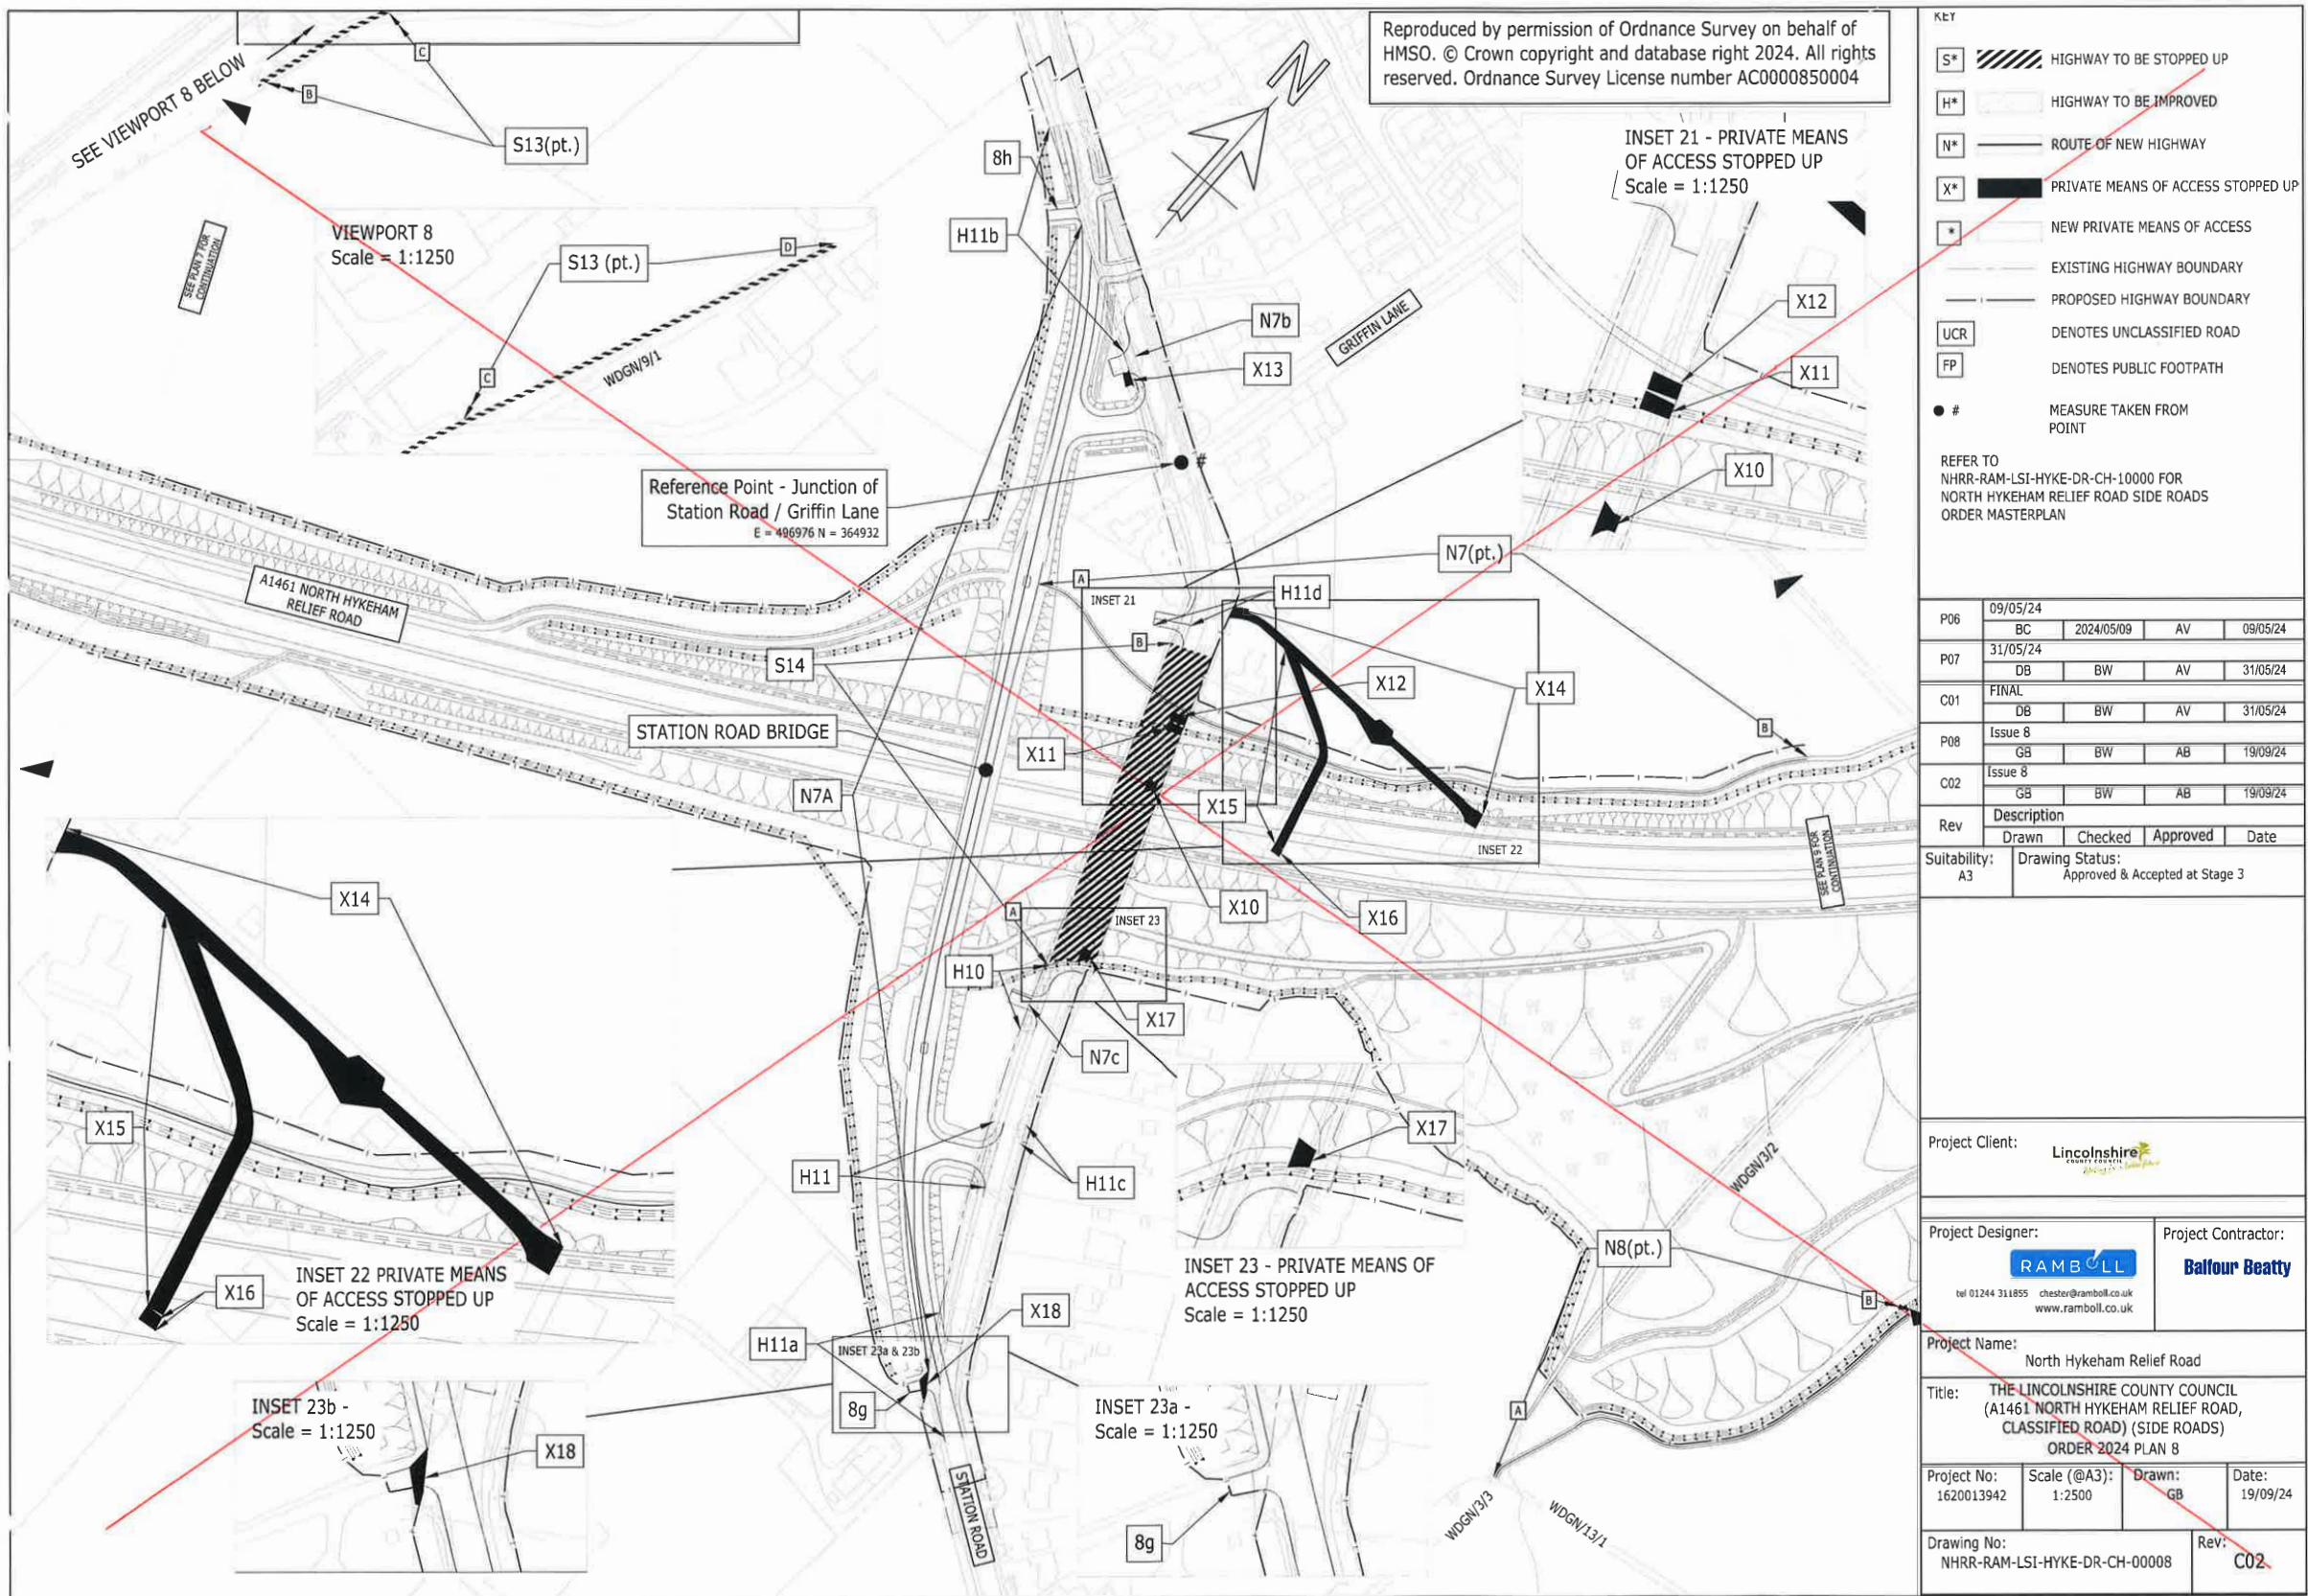


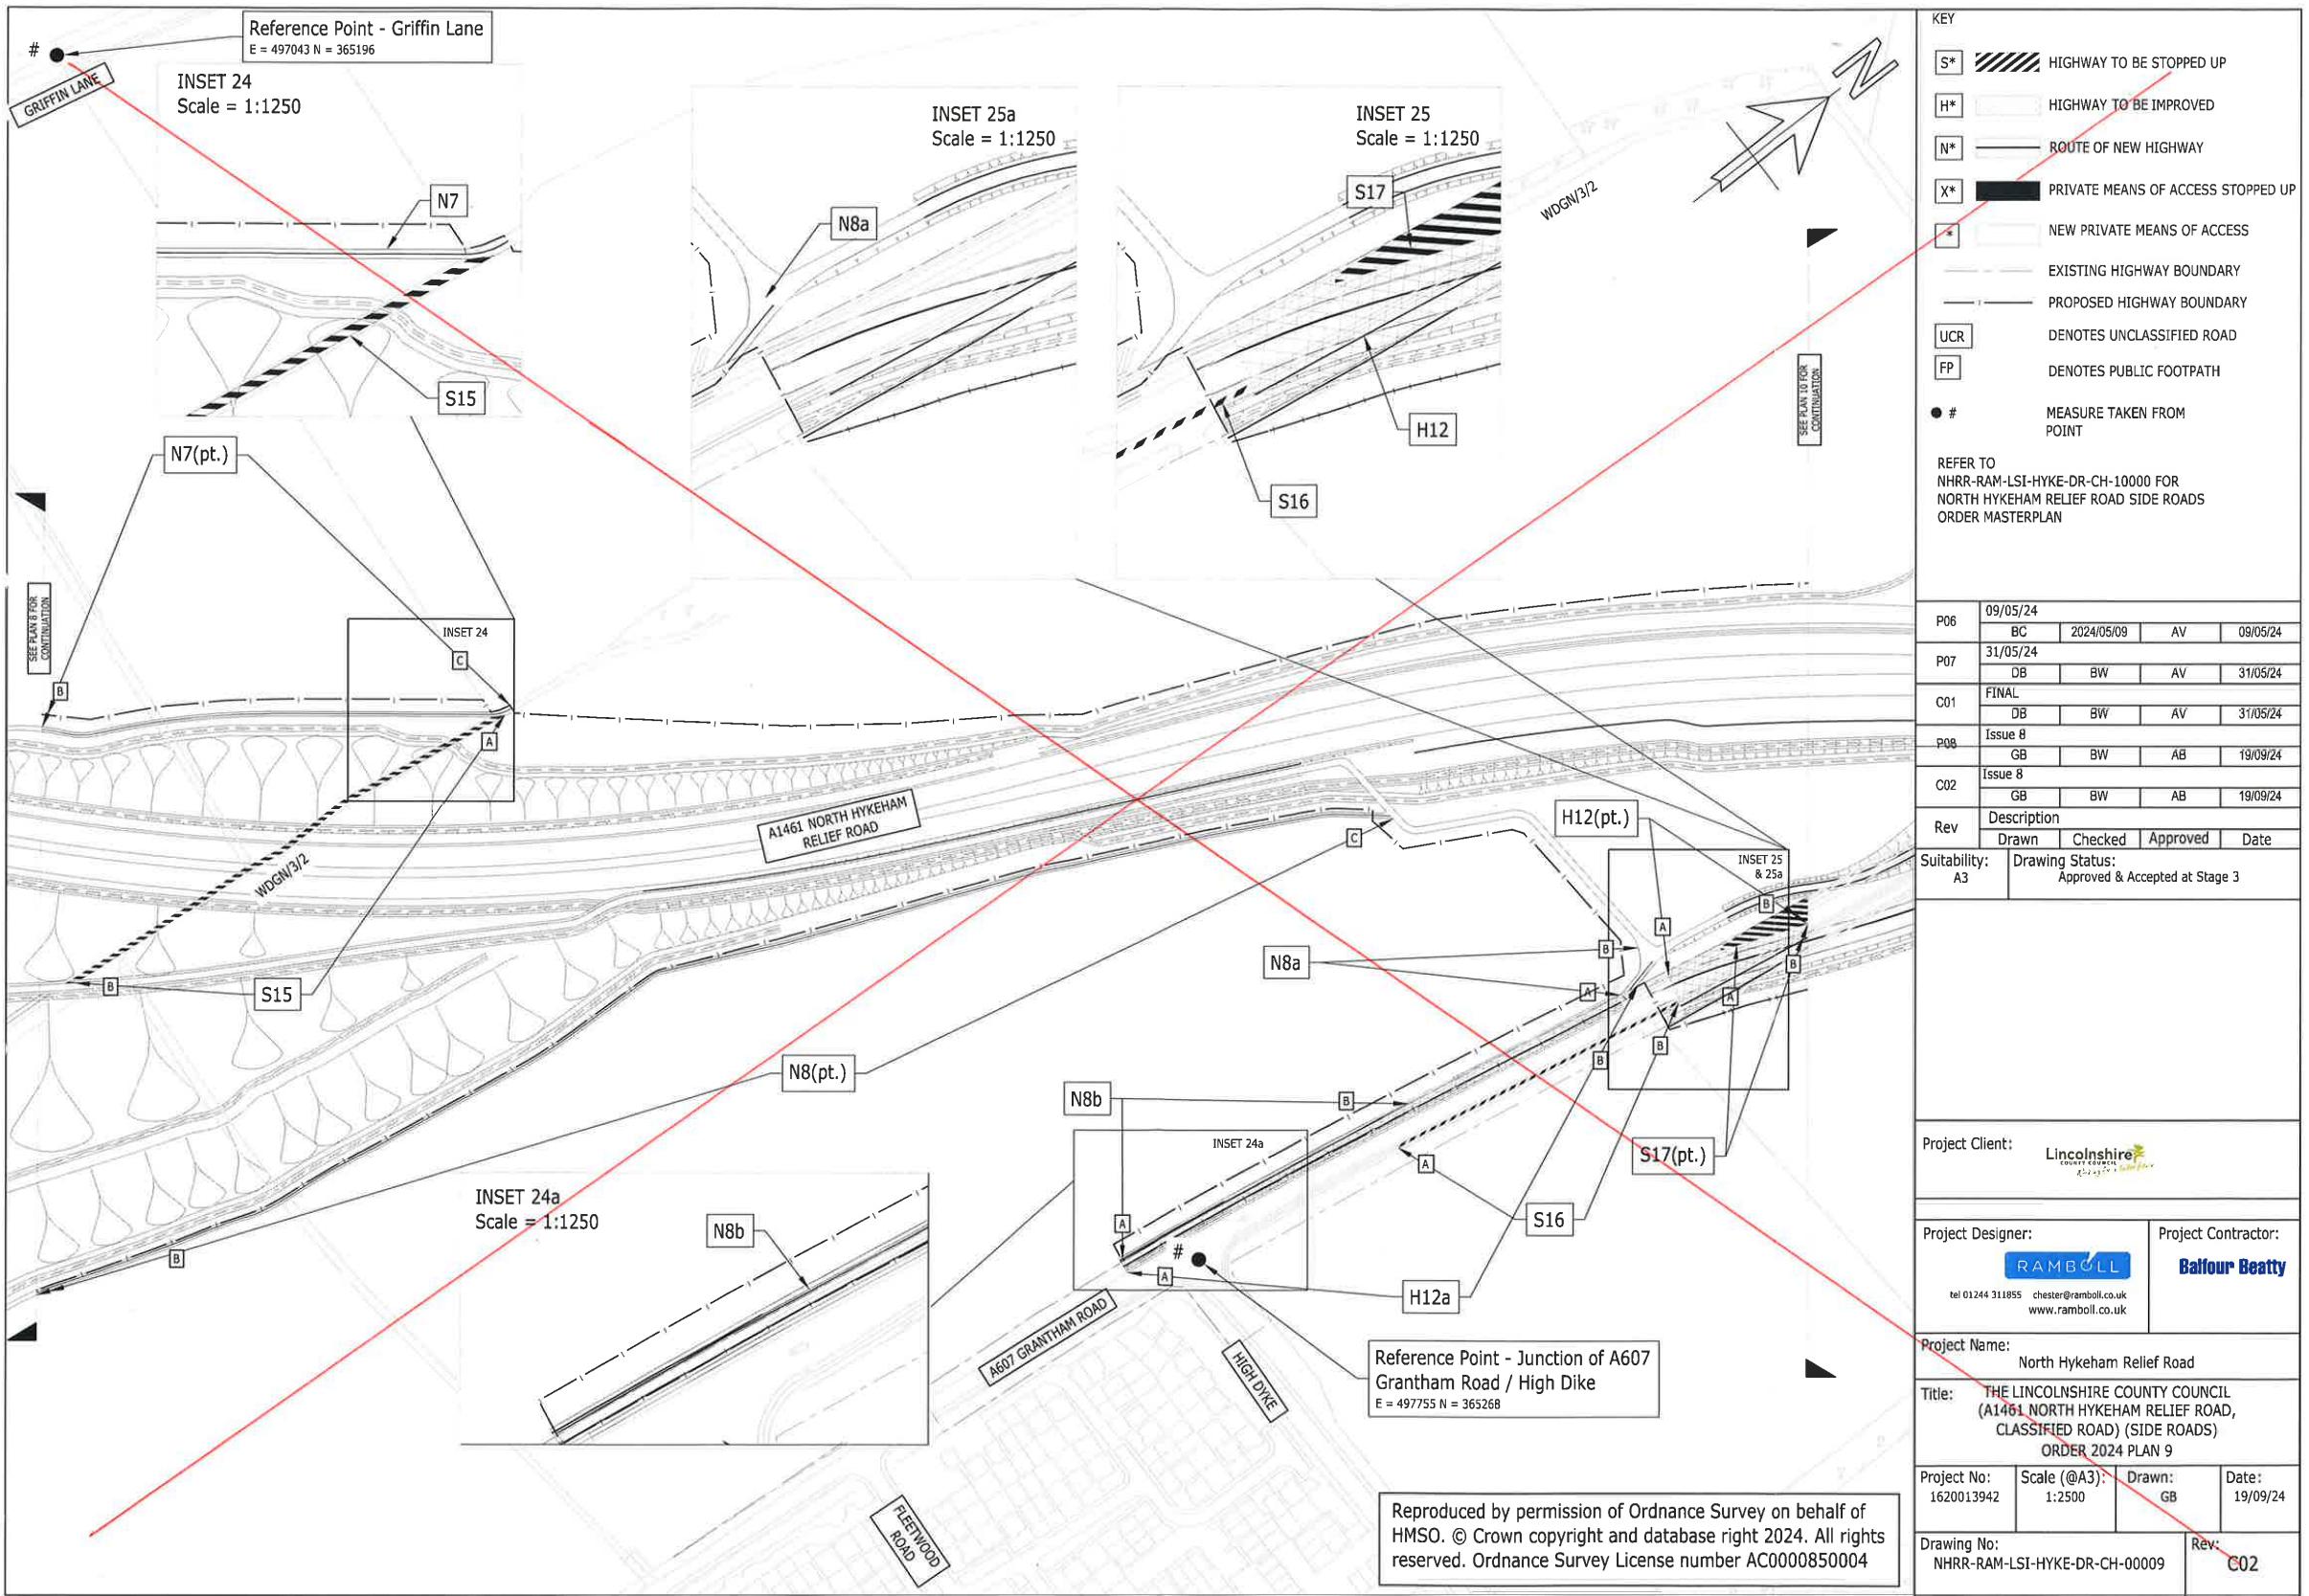


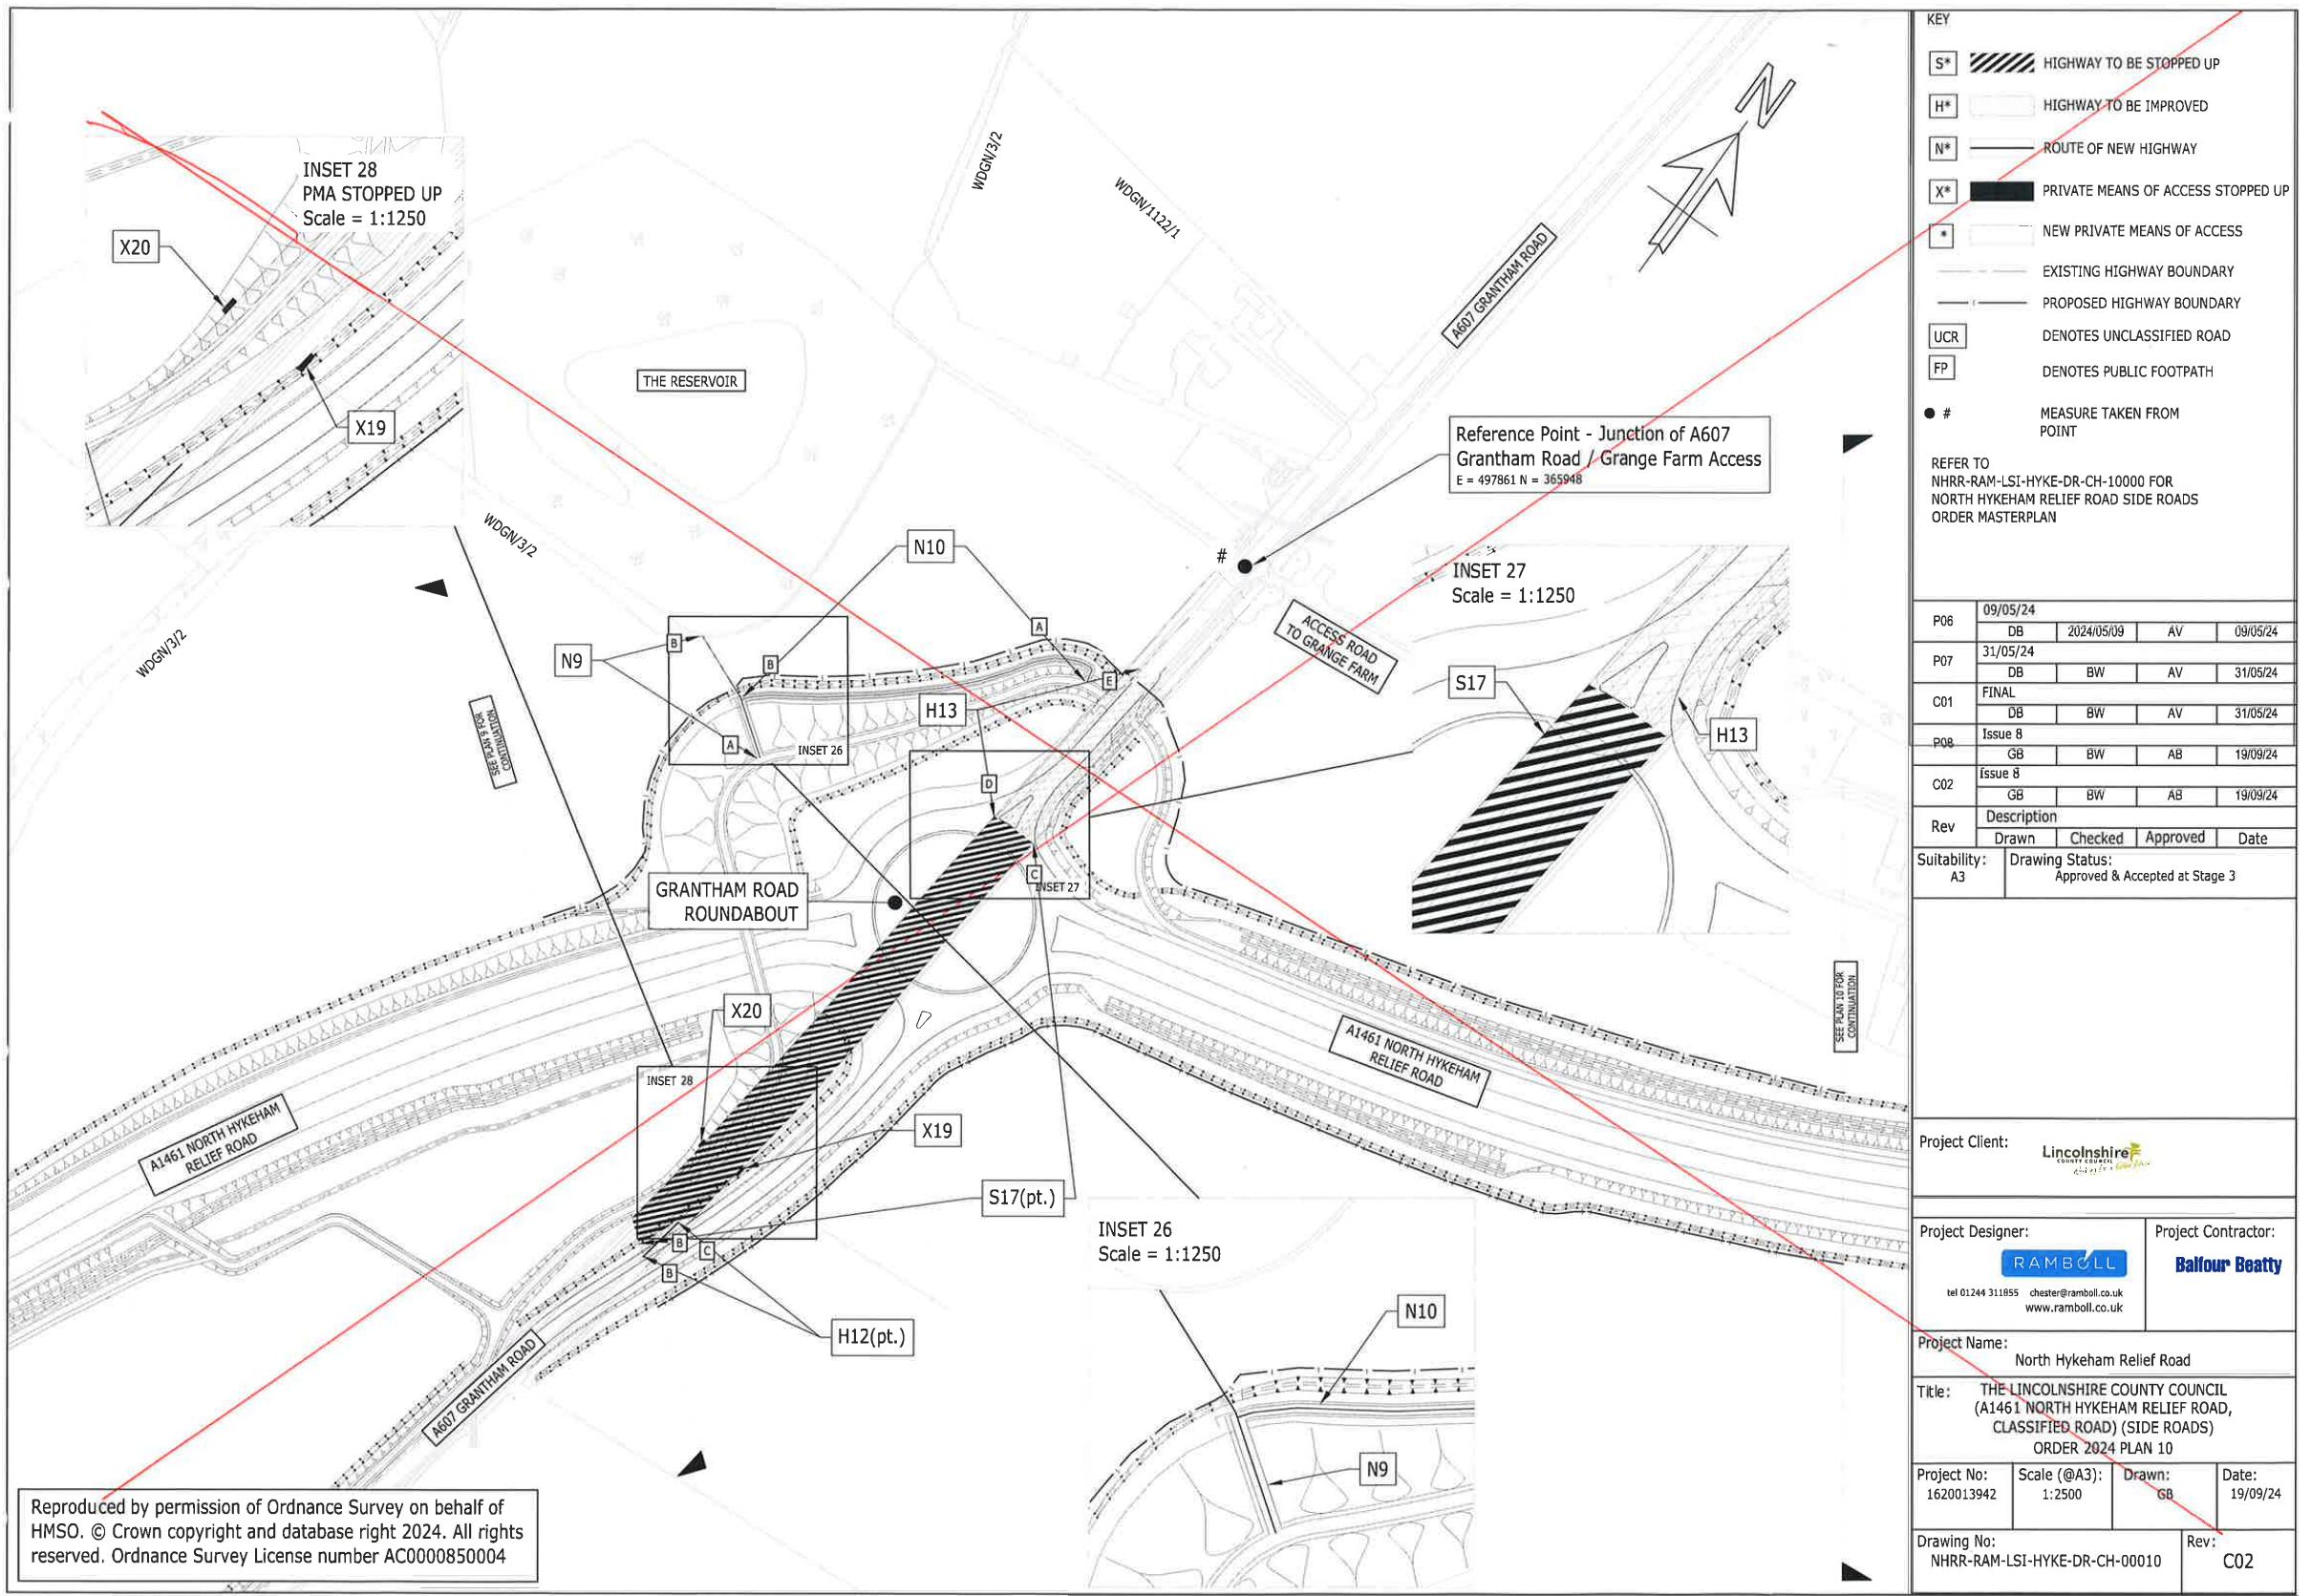

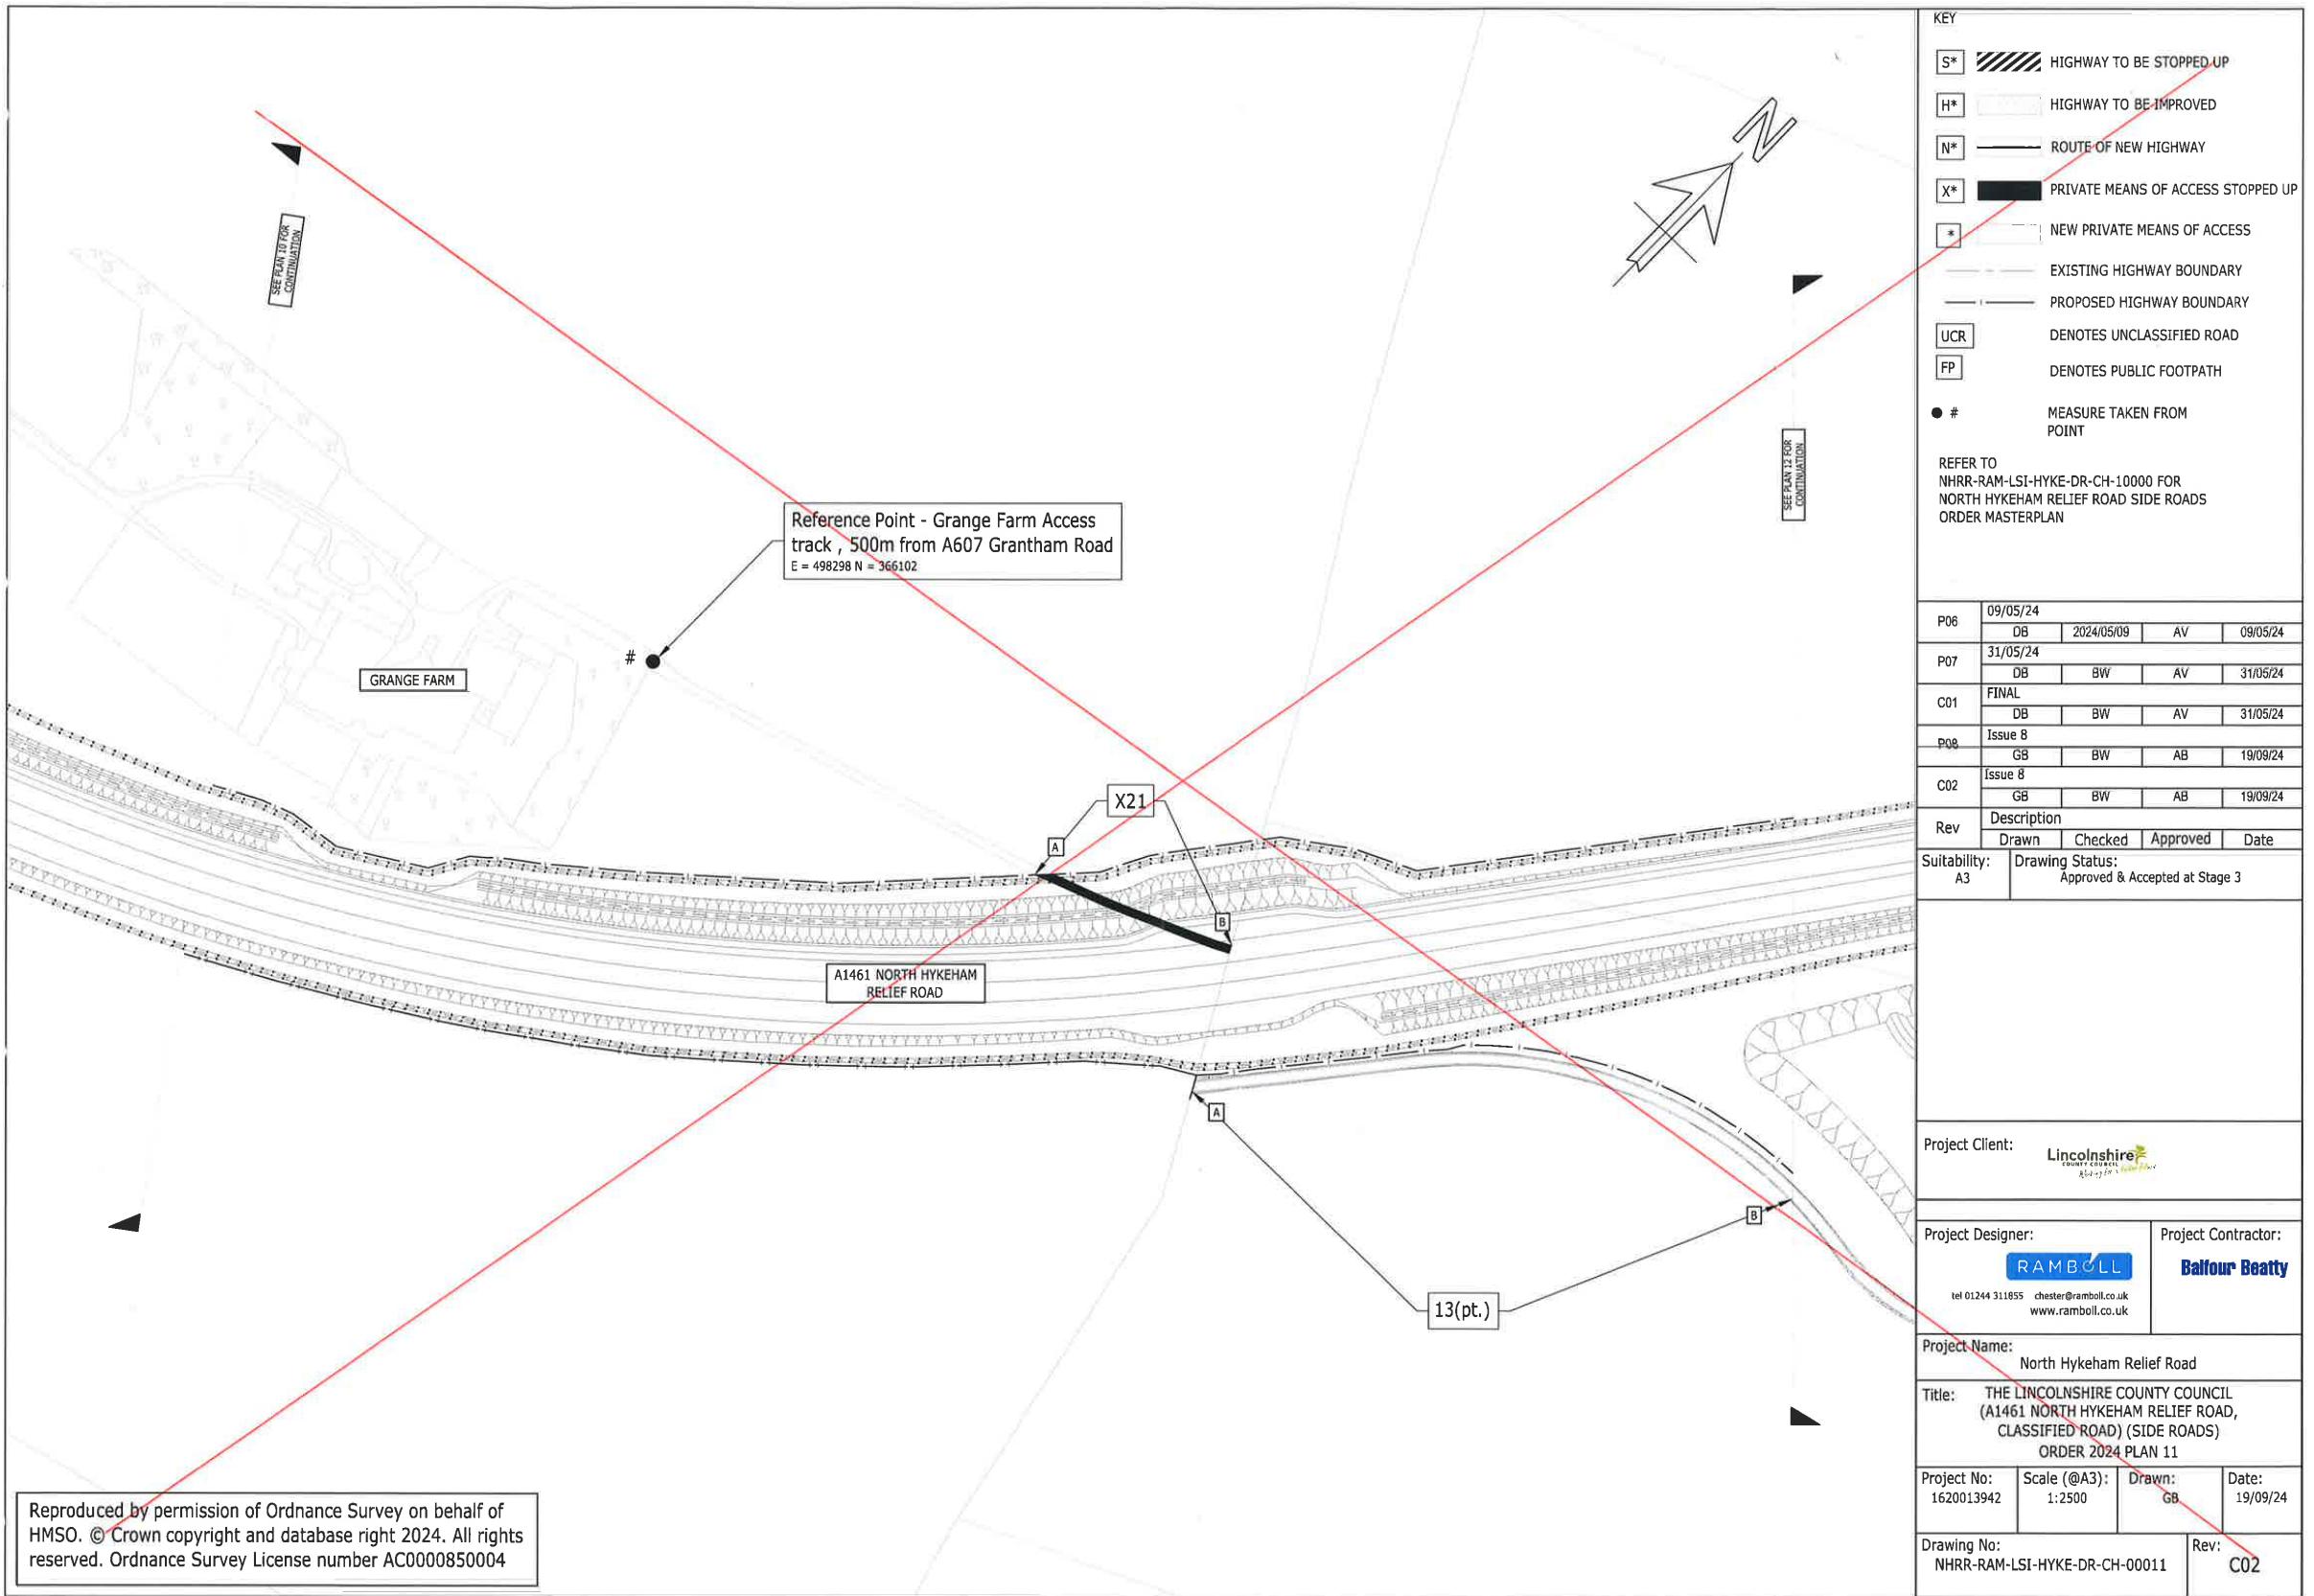

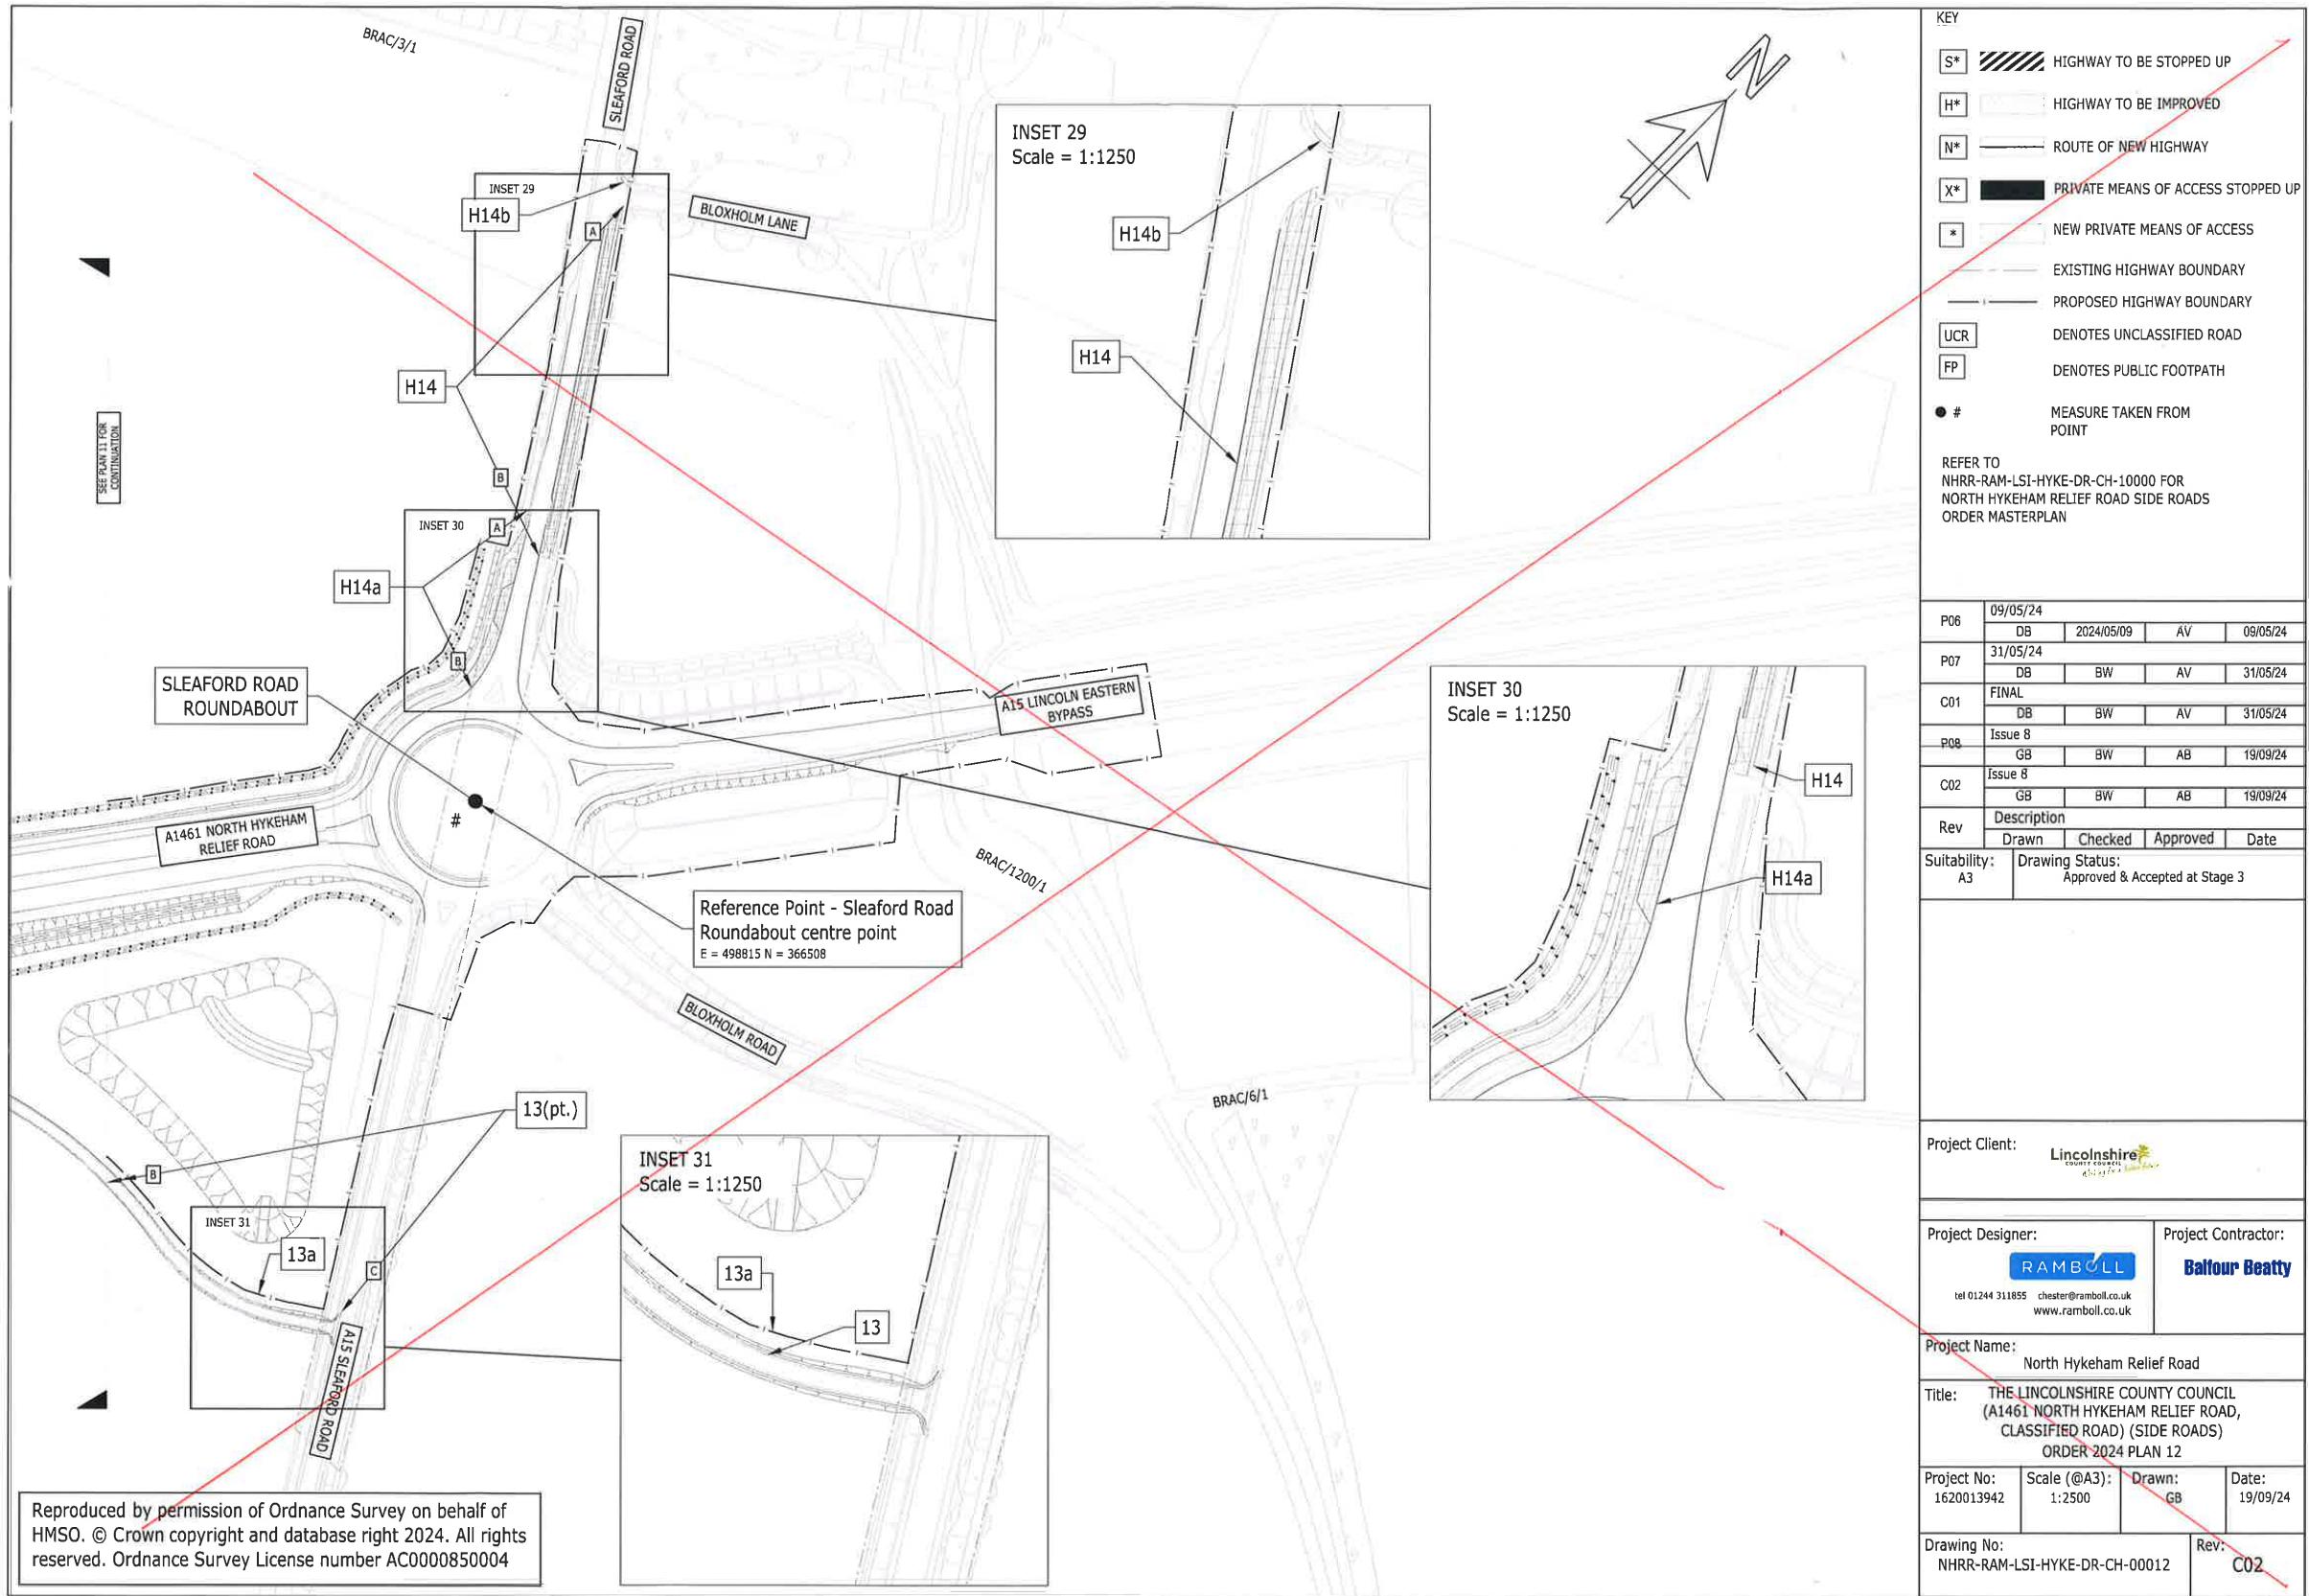

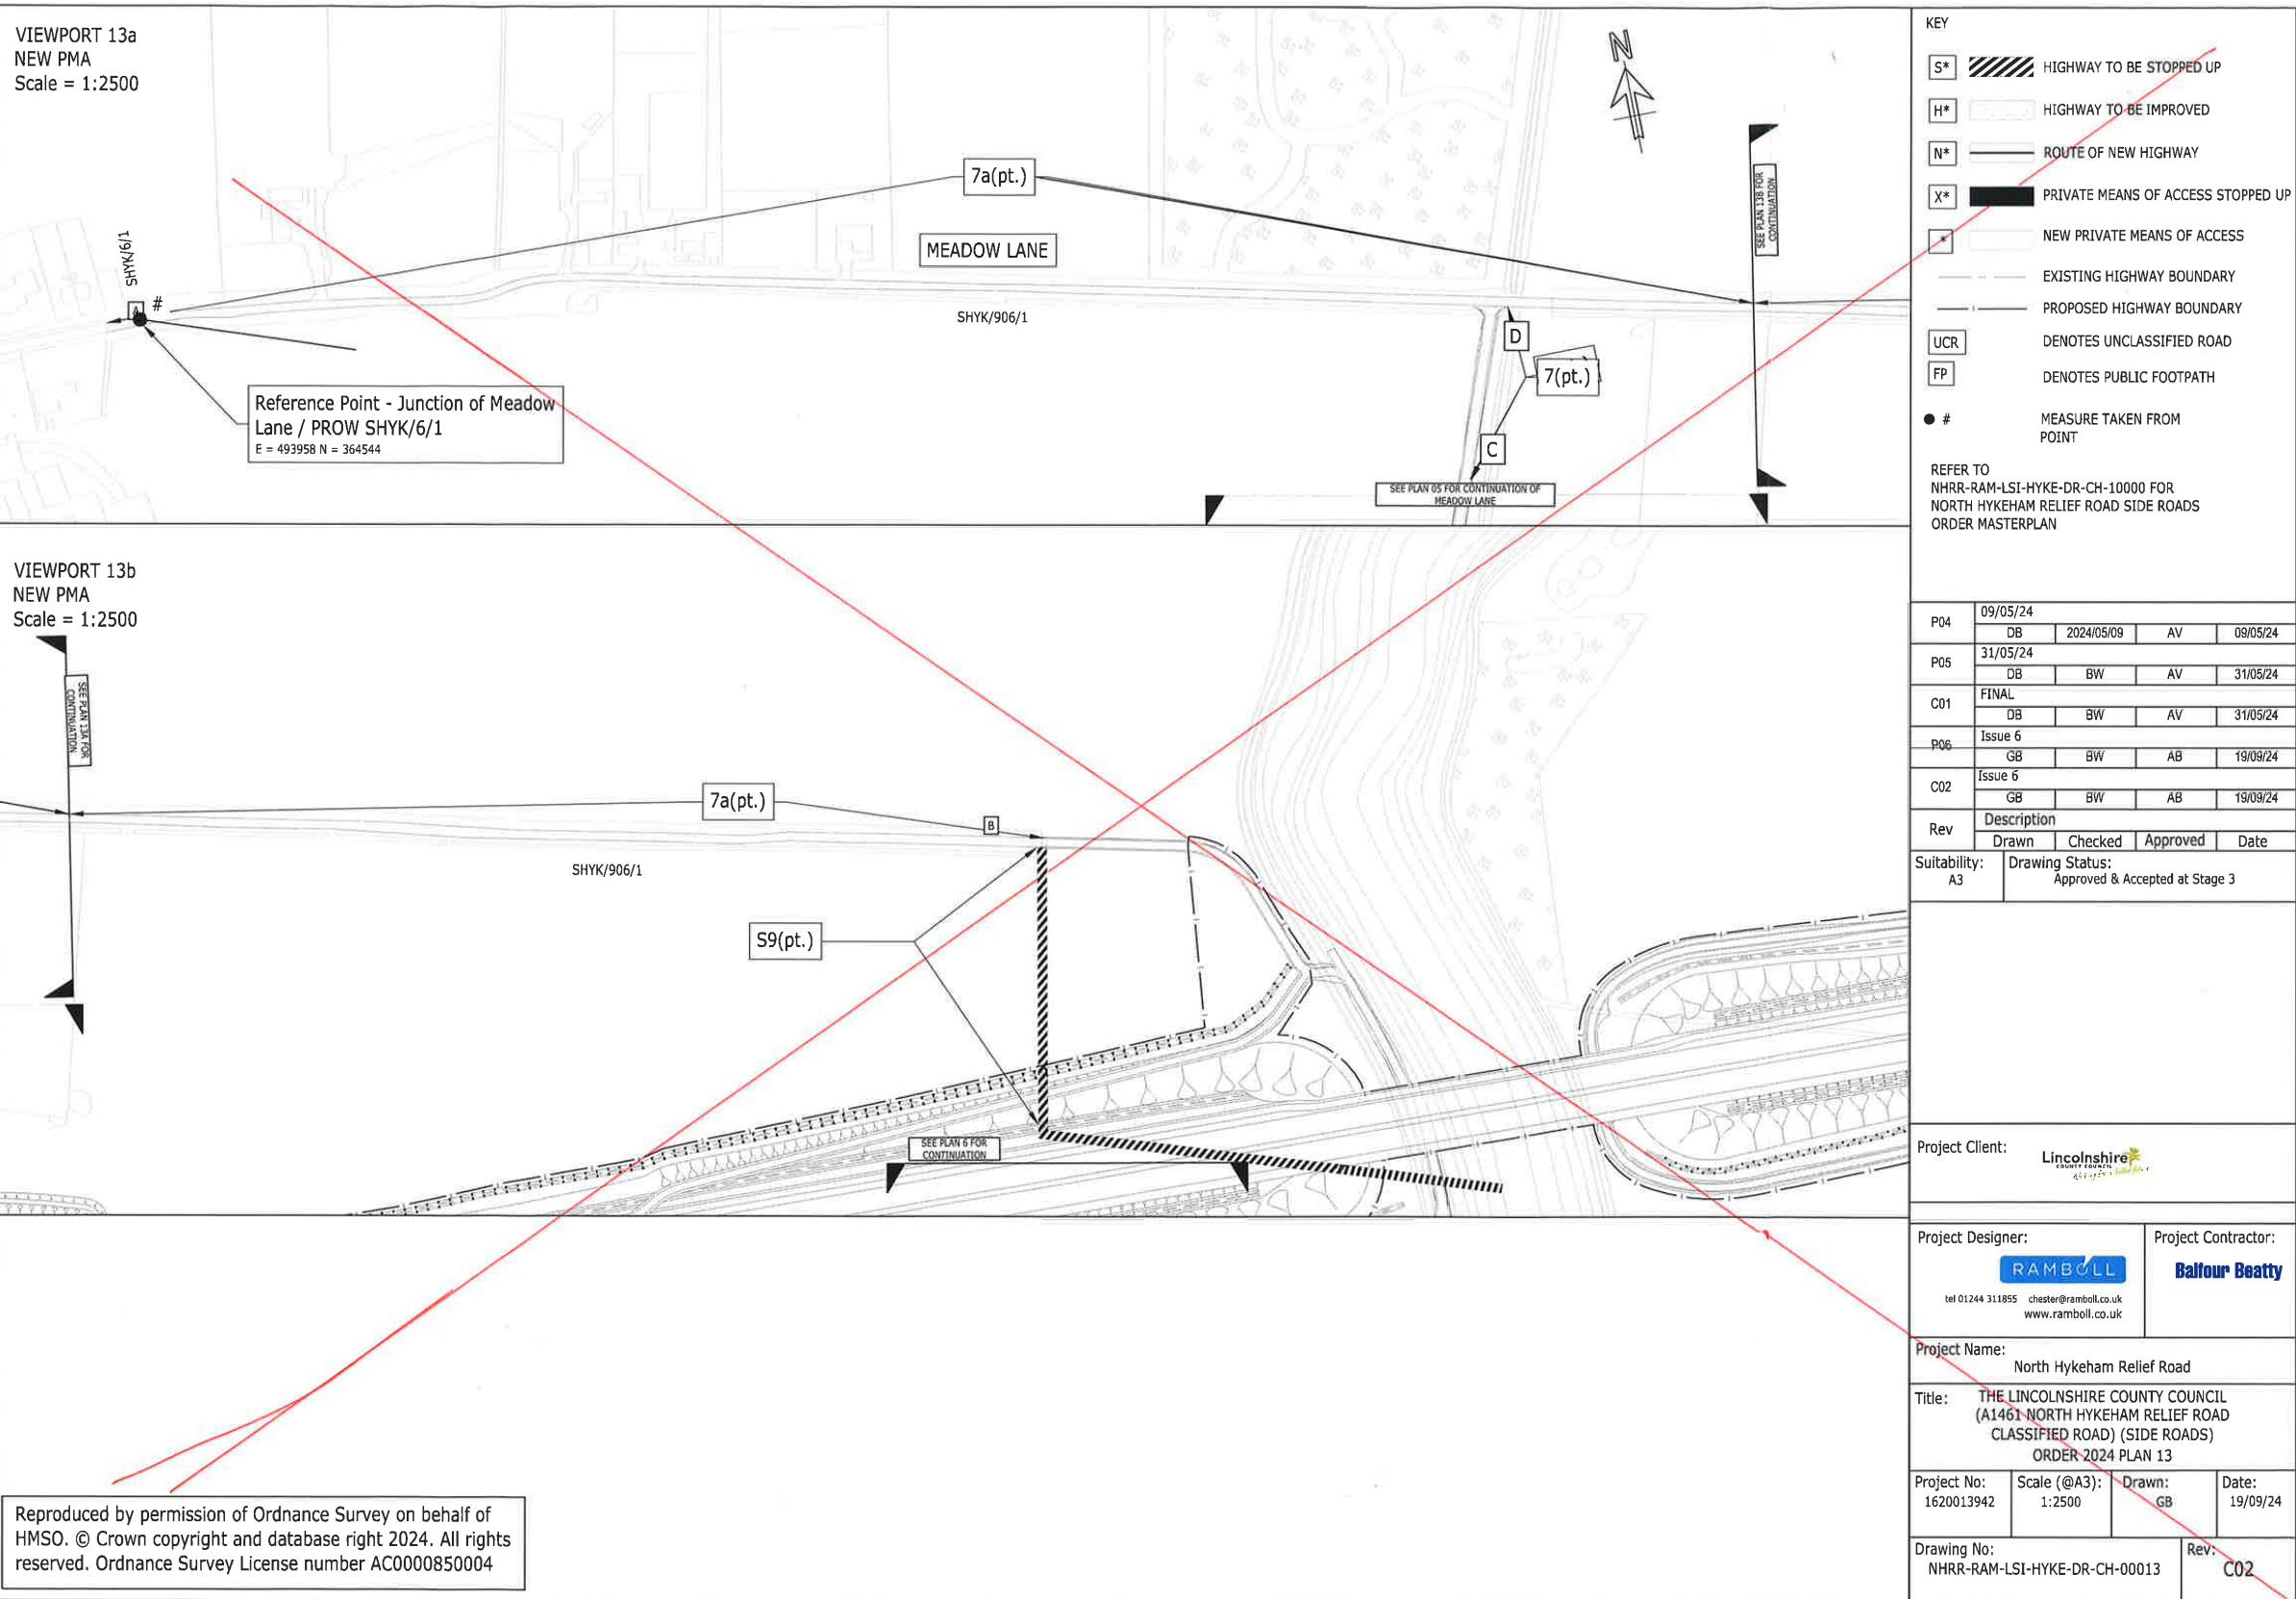

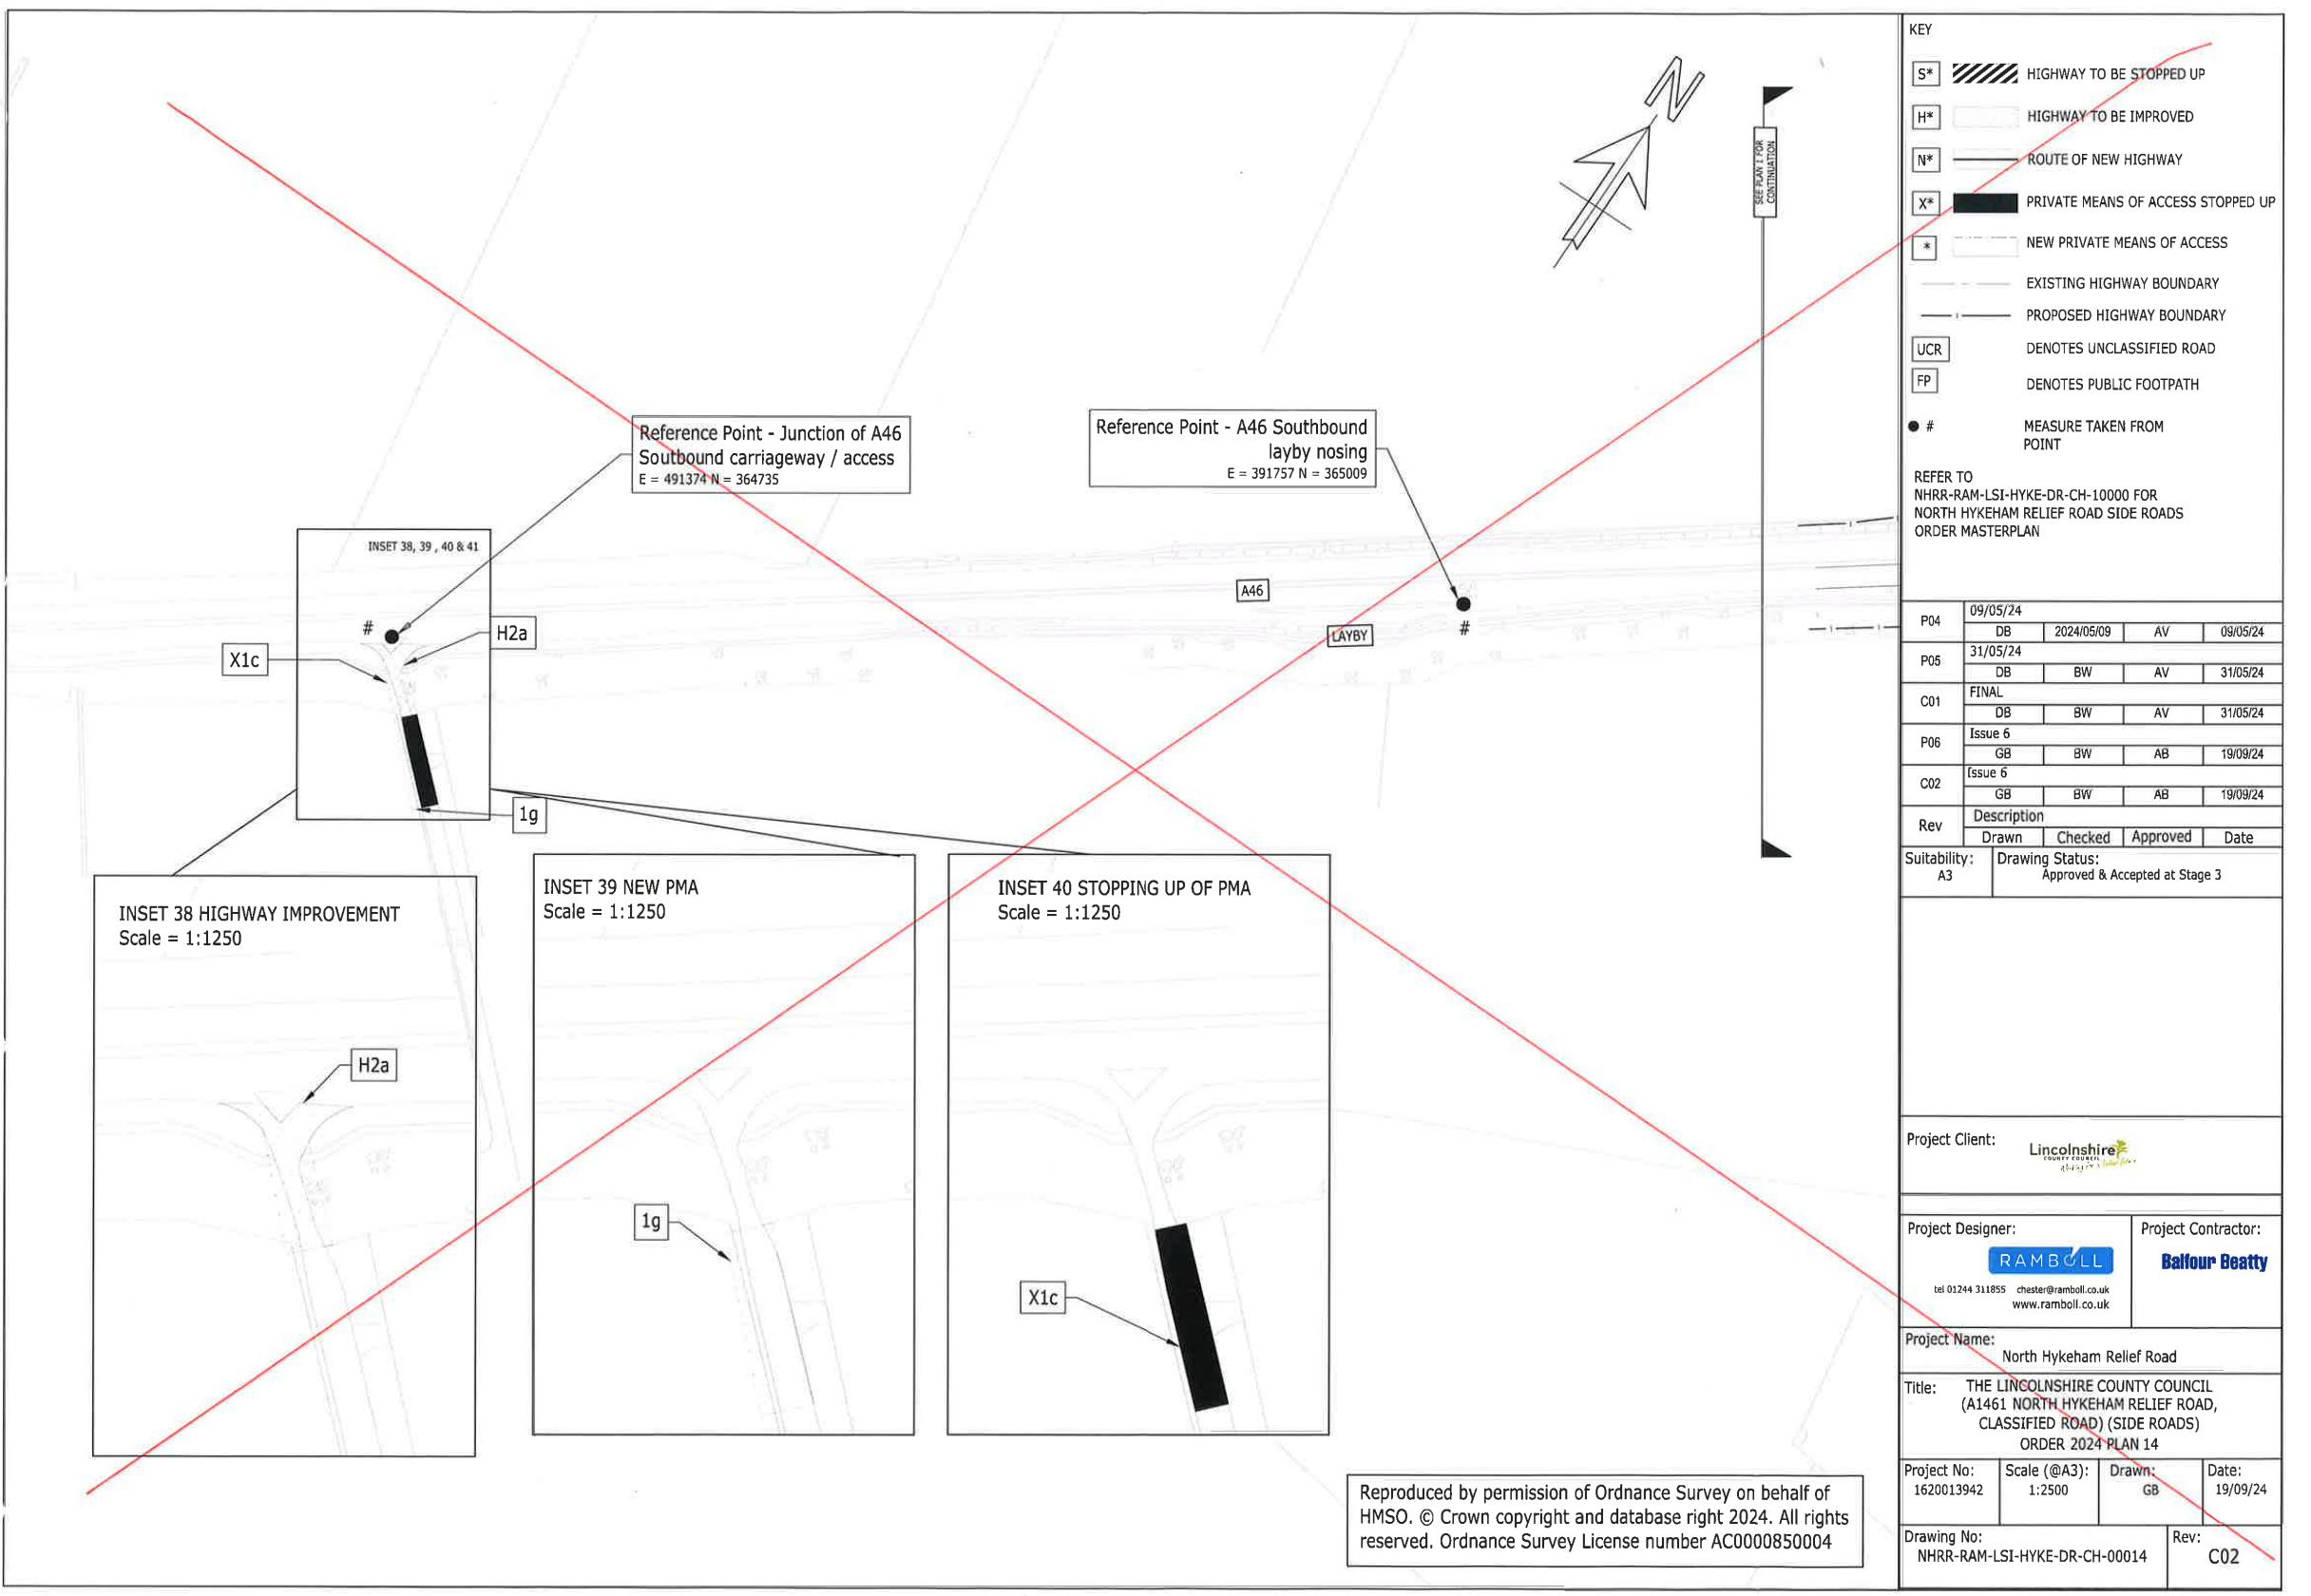

**THE LINCOLNSHIRE COUNTY COUNCIL (A1461 NORTH HYKEHAM RELIEF ROAD)  
(CLASSIFIED ROAD) (SIDE ROADS) ORDER 2024**

The Secretary of State for Transport hereby confirms the foregoing Order with modifications shown by red ink alterations. The Secretary of State is satisfied -

- (a) as respects each highway the stopping up of which is authorised by the Order, that another reasonably convenient route is available or will be provided before that highway is stopped up, and
- (b) as respects each private means of access the stopping up of which is authorised by the Order, that other reasonably convenient means of access to the relevant premises are available or will be provided in pursuance of the Order before that private means of access is stopped up or that no access to the relevant premises is reasonably required.

This document has been signed by way of an electronic signature.



Signed by authority  
of the Secretary of State  
30 October 2025

SAMANTHA COLLINS-HILL  
A Senior Civil Servant in the  
Department for Transport